T.6 S. R.2 W.W.M.

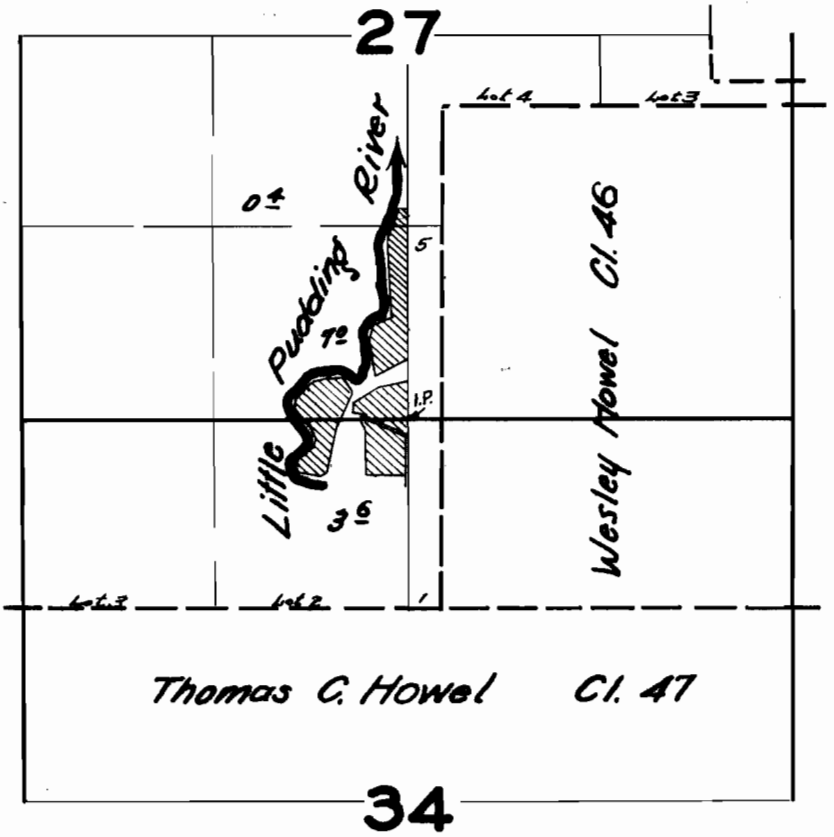

FINAL PROOF SURVEY

UNDER

Application No. 23723 Permit No. 18734

IN NAME OF

EARL J. WILSON

Surveyed Aug. 20, 1952, by H. L. COFFMAN

1952 F