


T. 8 S. R. 1 W. W. M.

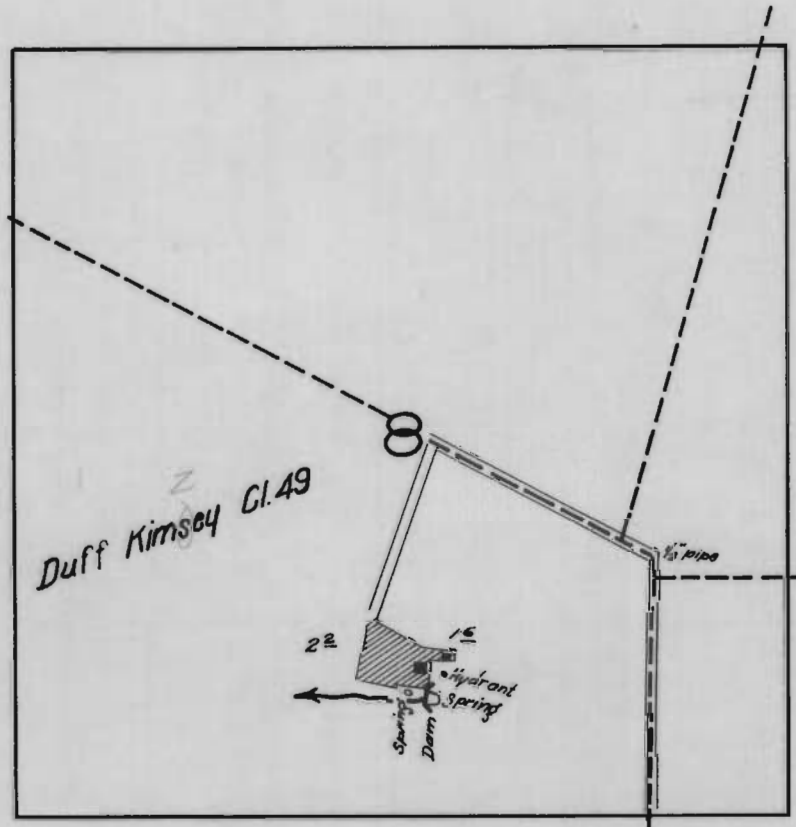

**FINAL PROOF SURVEY**

UNDER

Application No. 20606 Permit No. 16124

IN NAME OF

CLARENCE GOFFIN

Surveyed August 4 1952, by H. L. COFFMAN