


T.4S. R13 E.W.M.

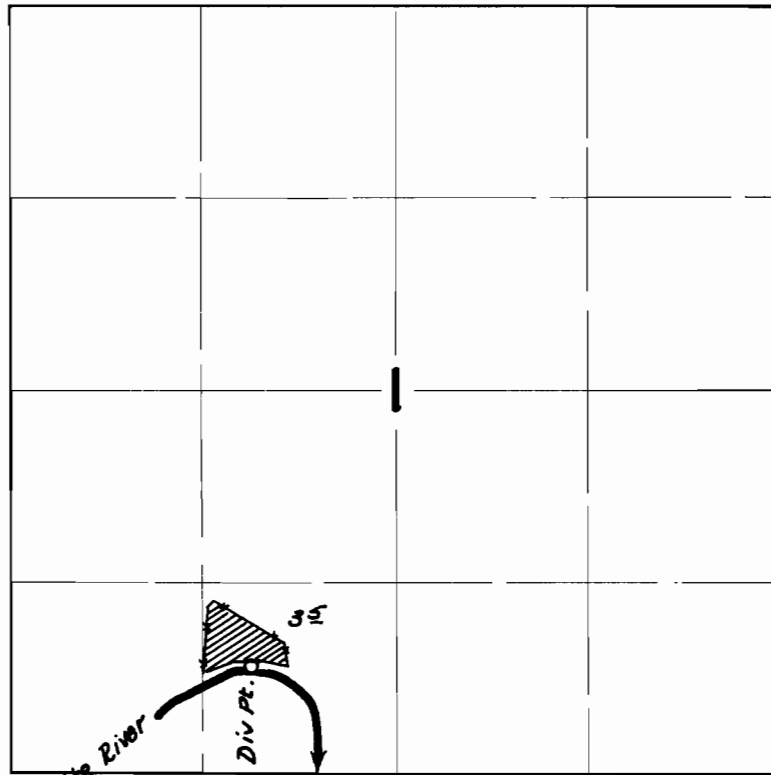

FINAL PROOF SURVEY

UNDER

Application No. 21884 Permit No. 17206

IN NAME OF

R. L. ASHLEY

Surveyed July 13 19 50, by H. L. COFFMAN