


T. IN. R. 4 W. W. M.

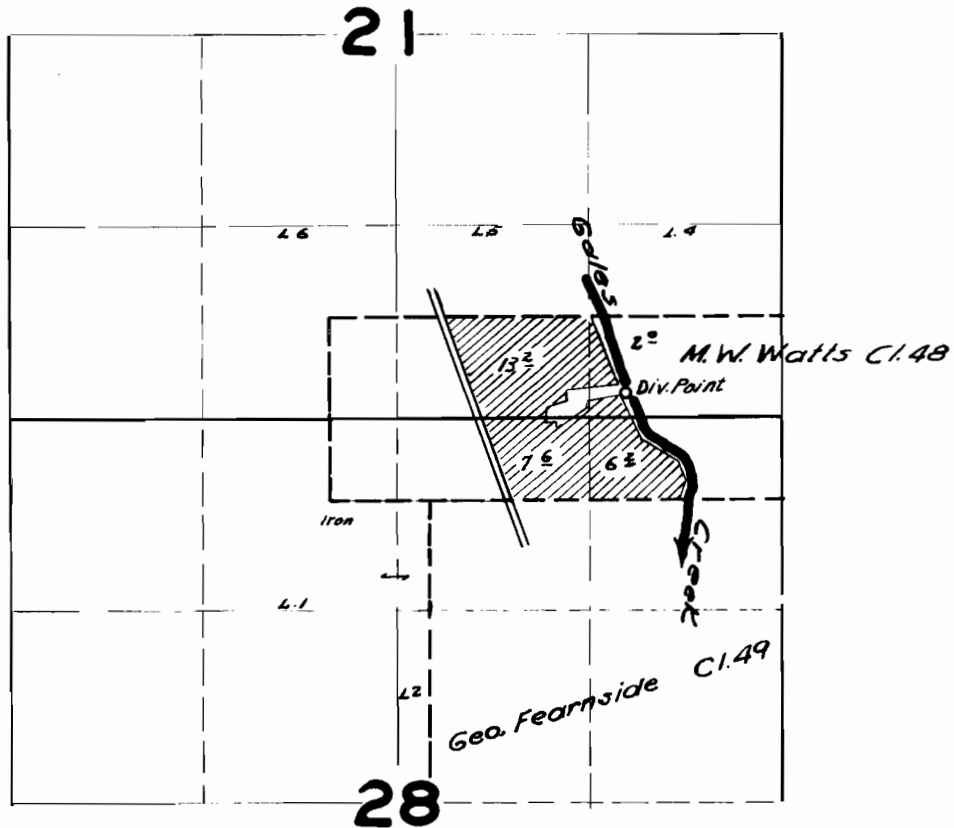

FINAL PROOF SURVEY UNDER

Application No. **20745** Permit No. **16318**

IN NAME OF

FRED OBERG

Surveyed 4 / 21 19 52, by H. G. COFFMAN