


T. 36 S., R. 6W., W.M.

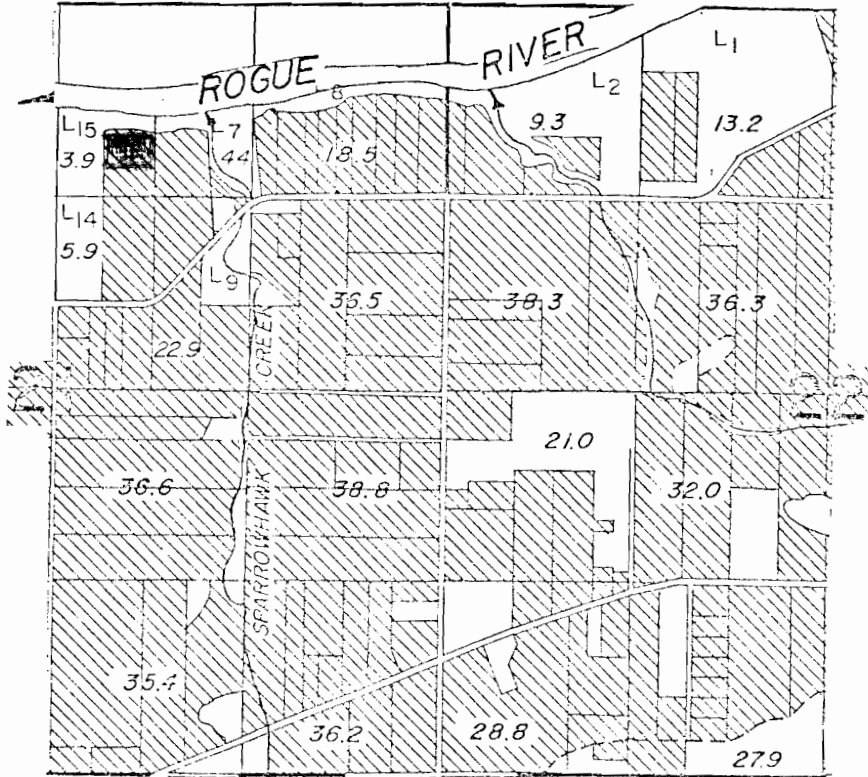

**FINAL PROOF SURVEY**  
UNDER

Application No. 5189 Permit No. 8853

IN NAME OF

**Grants Pass Irrigation District**

Surveyed ..... 19..... by W.R.D. ....

10  
MK  
022