


Sec's. 7-12, T.35S. R. 1 & 2 W.W.M

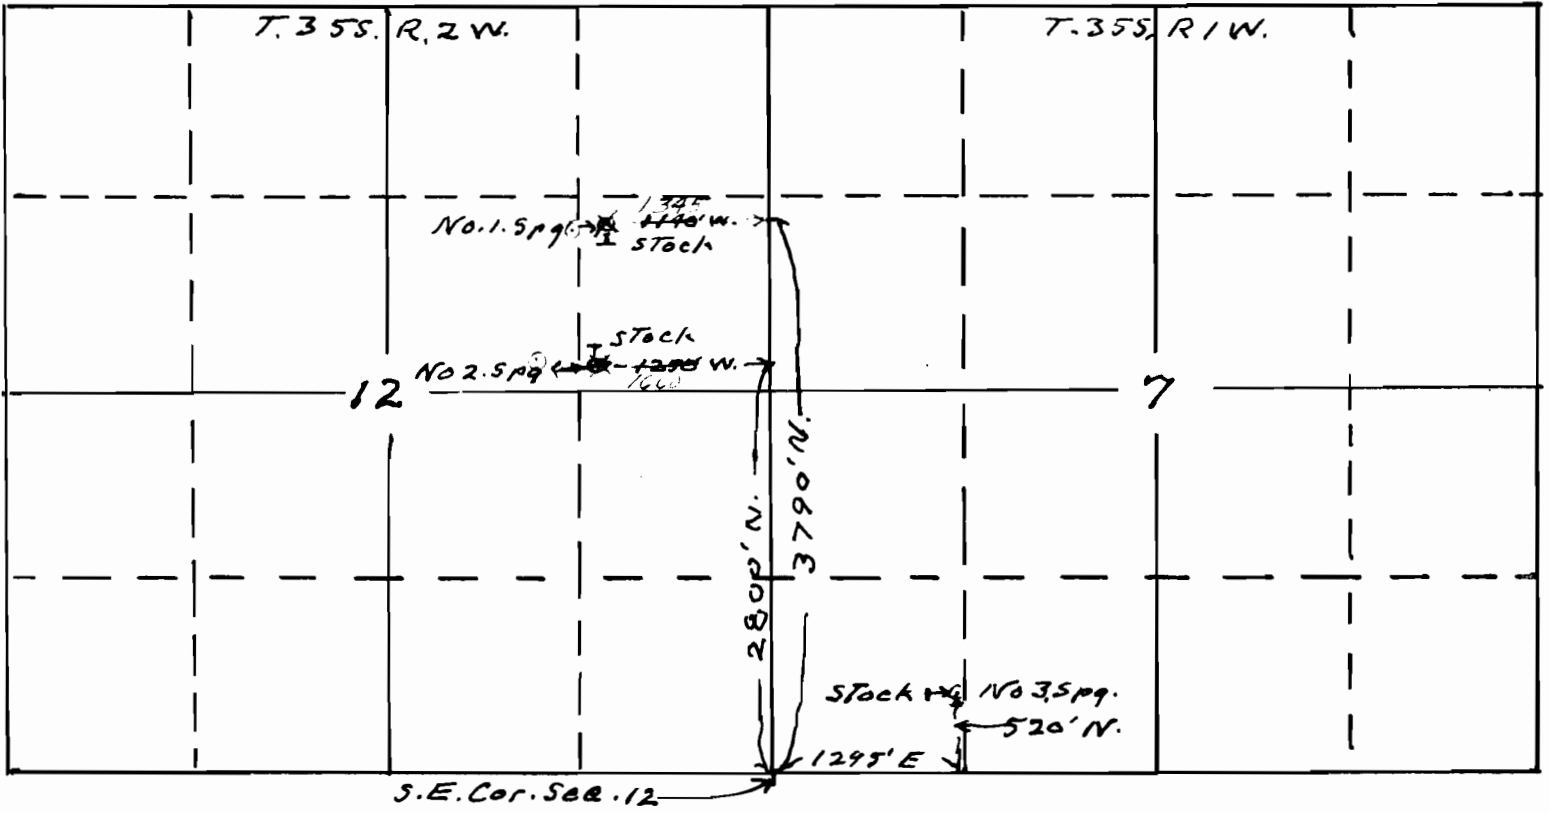

Map to accompany application of  
 Margarite Wood for use of three  
 private springs for stock purposes

This office 10/27/48 *Smith*

Application No 23541  
 Permit No. 18000