


P-1400

2022

Township 13 S.
Range 31 E.

A-2613
P-1400

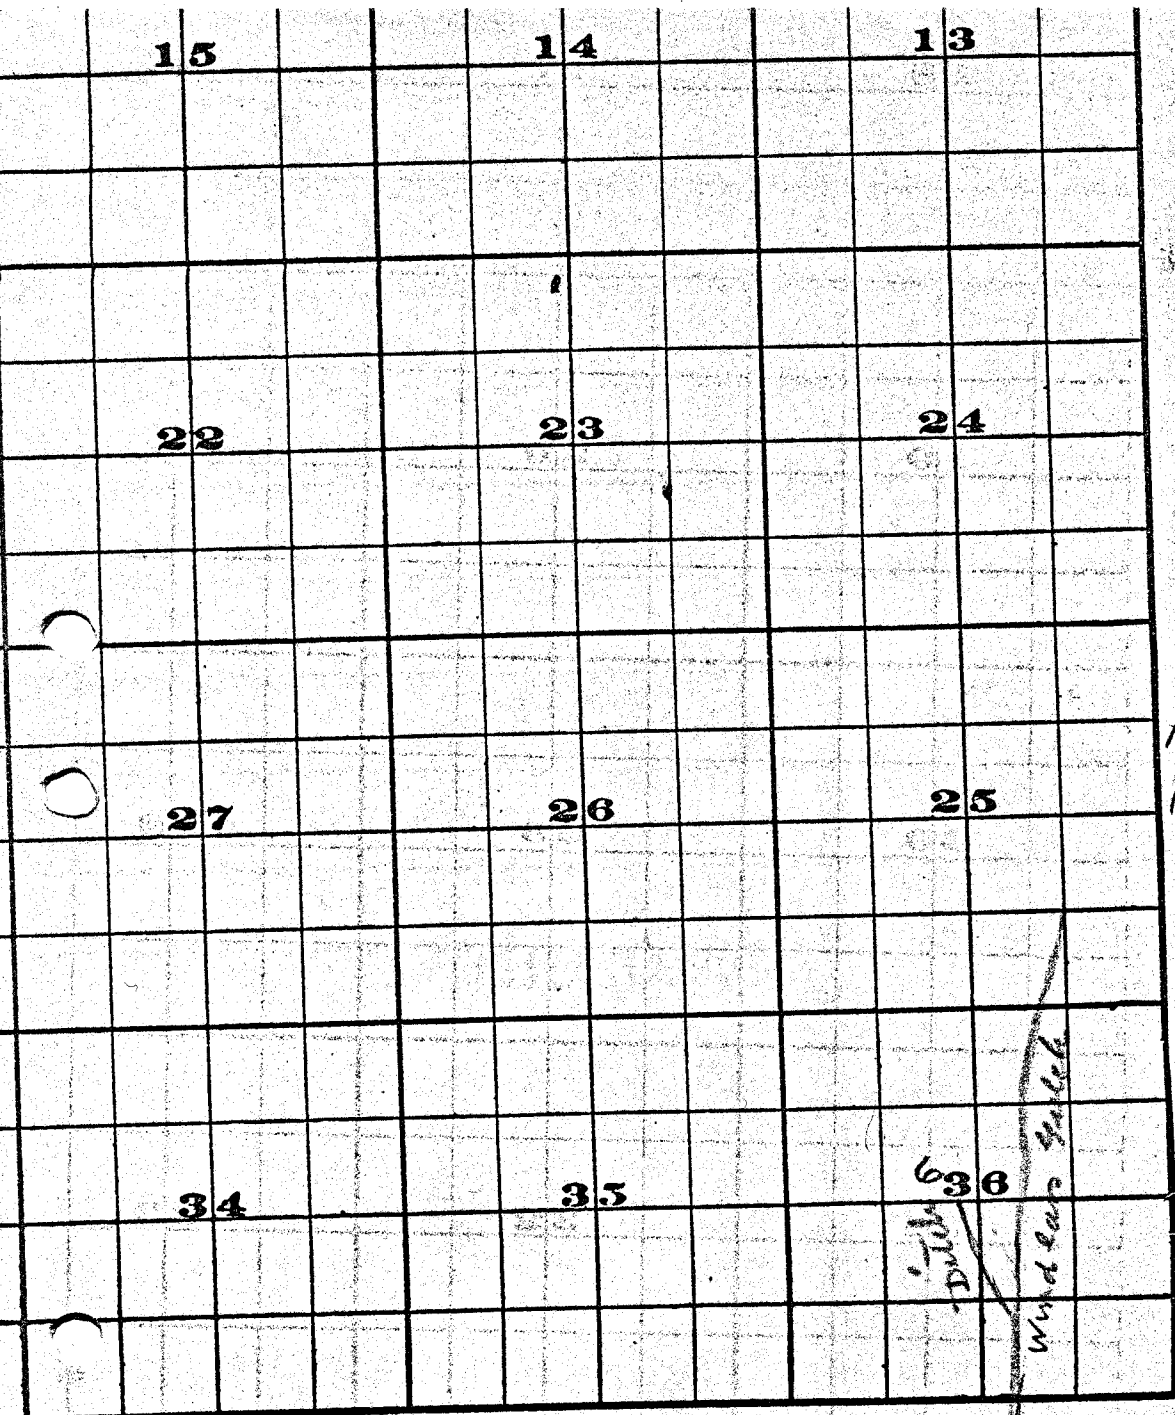


