


TOWNSHIP 34S, RANGE 1E, W. M.

North

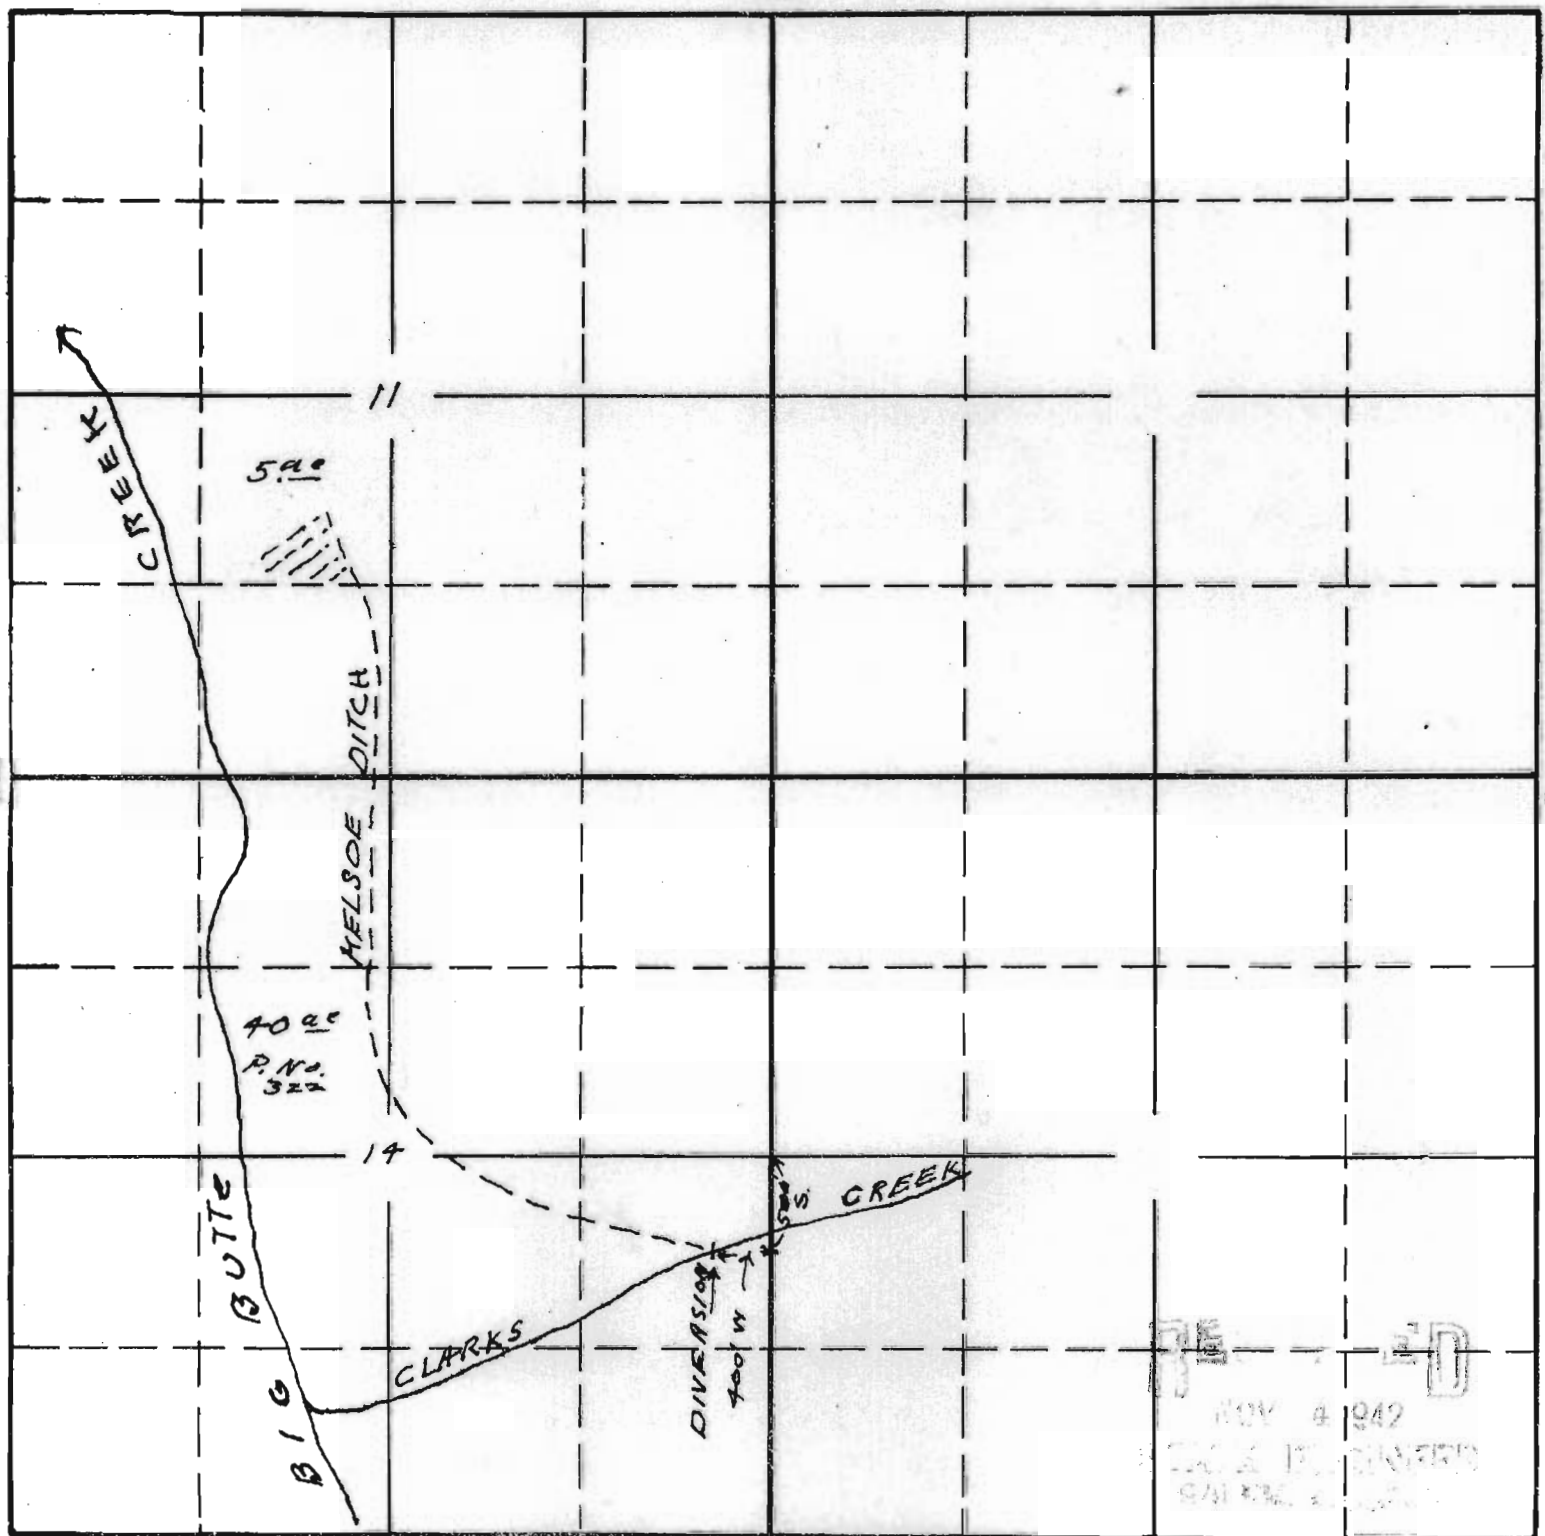

To accompany application of Harold M ^{South} Von Stein for Transfer of place of use from SE & NW & sec. 14 To NE & SW & sec. 11 T. 34 S. R. 1 E. W.M. Five acres of irrigation.

APPLICATION No.
PERMIT No.

This office 10/30/42 *W.H.H.*