


T. 8 S. R. 2 W. W.M.

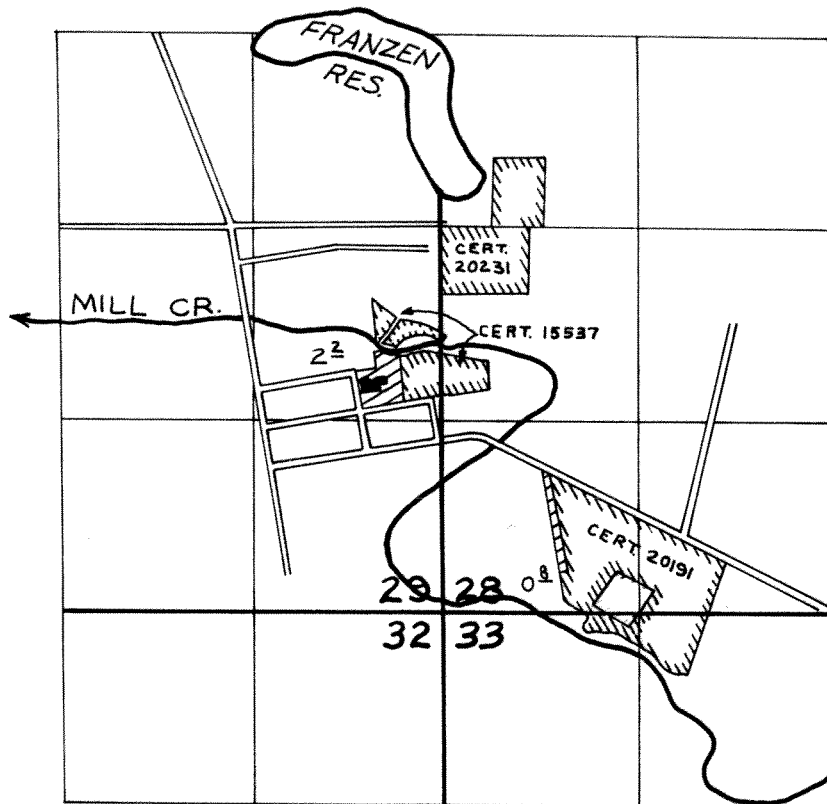

FINAL PROOF SURVEY

UNDER

Application No. E-81 Permit No. E-82

IN NAME OF

TURNER MEMORIAL HOME

Surveyed JUL 9, 19 79, by C. HUGHES