

East Av. Mac

OFFICE OF STATE ENGINEER  
FEECHER

OCT 12 1911

SALES & OFFICE

Application No. 1738

Permit No. 880


# PLAT

## ACERAGE IRRIGATED BY

### Osburn Ditch

Accompanying Application #1738

Scale: 1" = 40 chs.

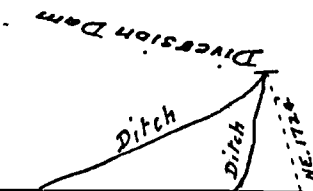

7-41 S R 12 E W M.

	30 a	30 a	
	40	40	20
	40	40	

A- 4284  
P- 2466

3321  
20234 RE  
880  
2466