


T.23S.R.30E.W.M.

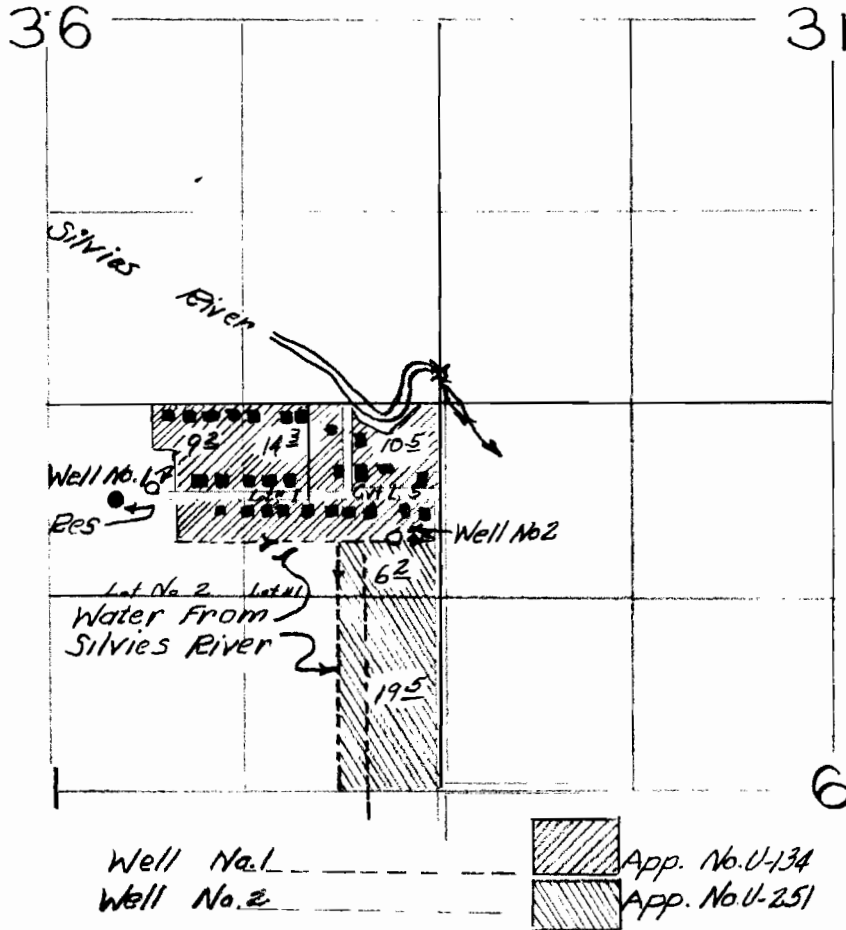

FINAL PROOF SURVEY

UNDER

U-134

U-126

Application No. U-251 Permit No. U-223

IN NAME OF

UNITED STATES OF AMERICA

copy of original final proof map.