


T.22S.R.31E.W.M.

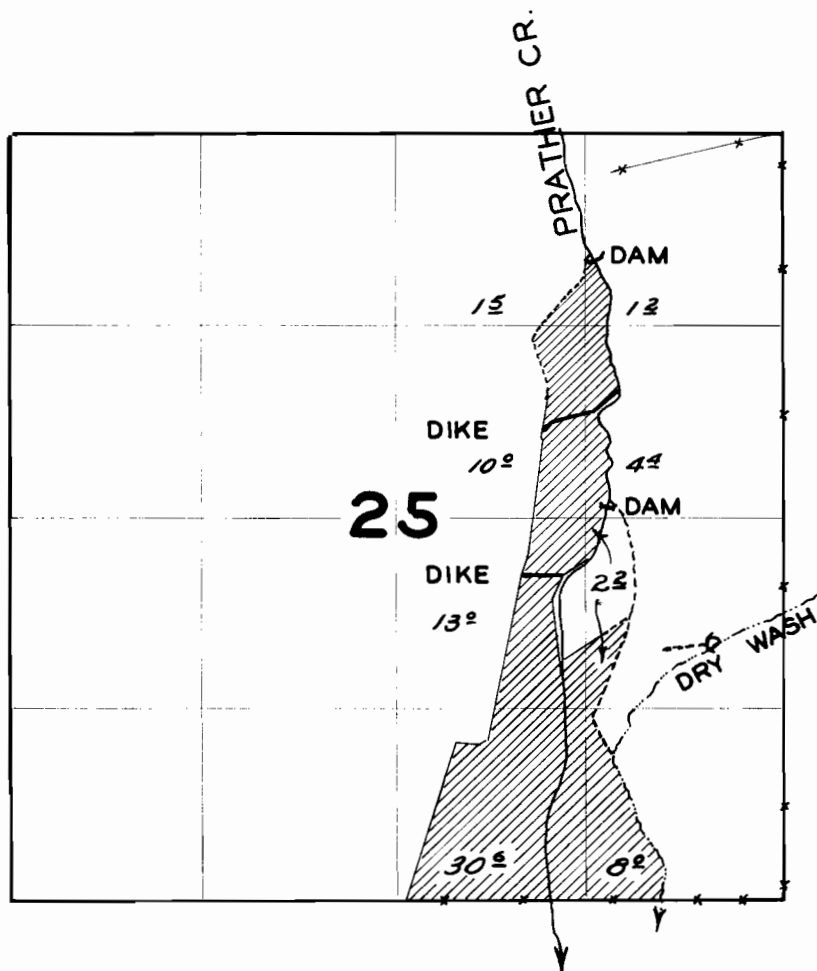

FINAL PROOF SURVEY

UNDER

Application No. 12882 Permit No. 9369

IN NAME OF

J.A. ARMSTRONG

Surveyed 7/19 1951 by H.L. COFFMAN