


T.22S.R.31E.W.M.

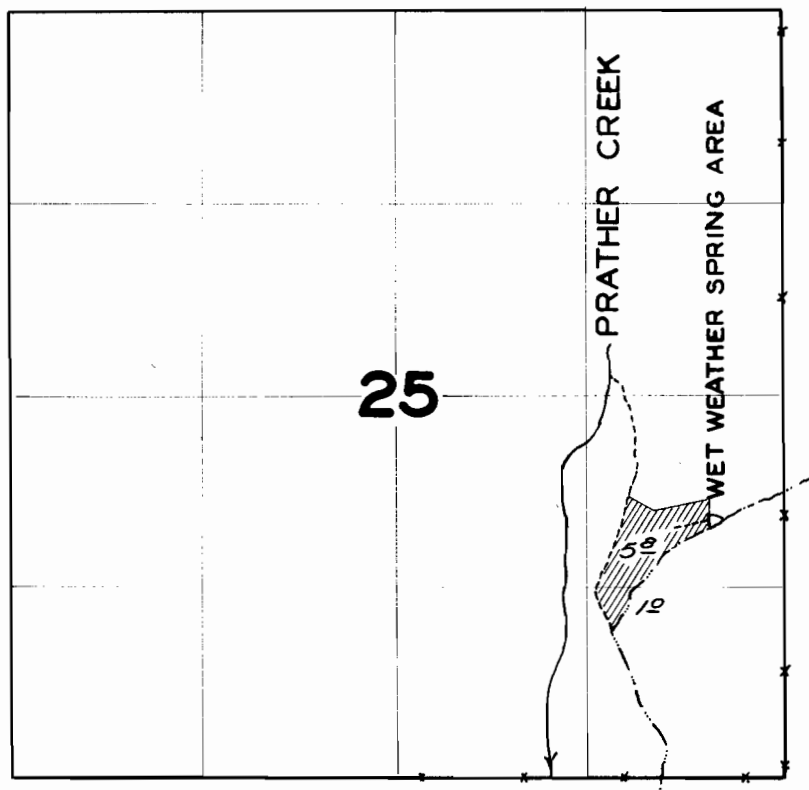

FINAL PROOF SURVEY
UNDER

Application No. 14622 Permit No. 10638
IN NAME OF

J.A. ARMSTRONG

Surveyed 7/19 1951, by H.L. COFFMAN