


T. 1 S. R. 3 W. WM

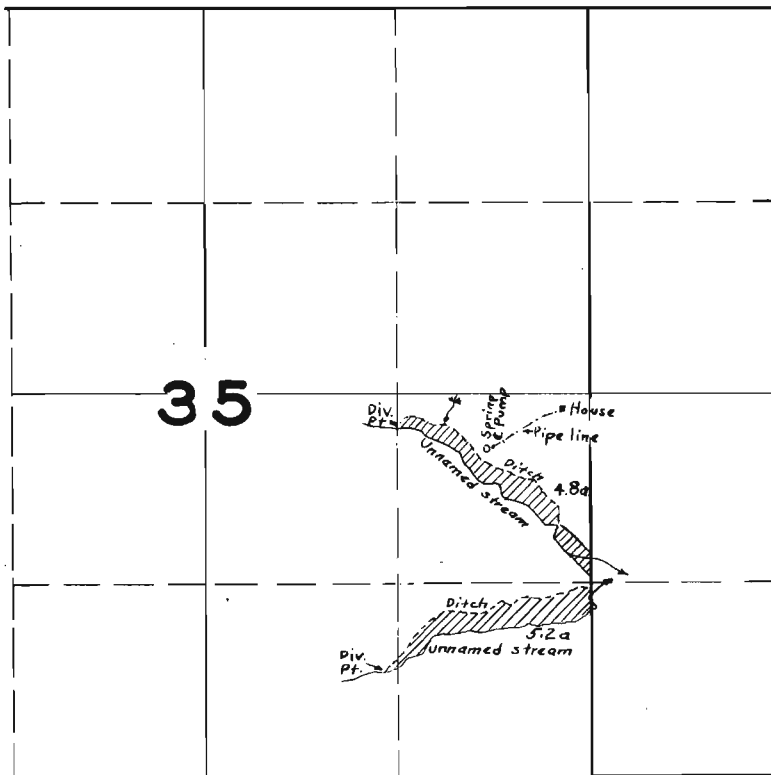

FINAL PROOF SURVEY UNDER

Application No. 18338 Permit No. 13998

IN NAME OF

HENRY PETERS

Surveyed April 1 1953, by H. L. Coffman