


T.8 S.R.4W.W.M.

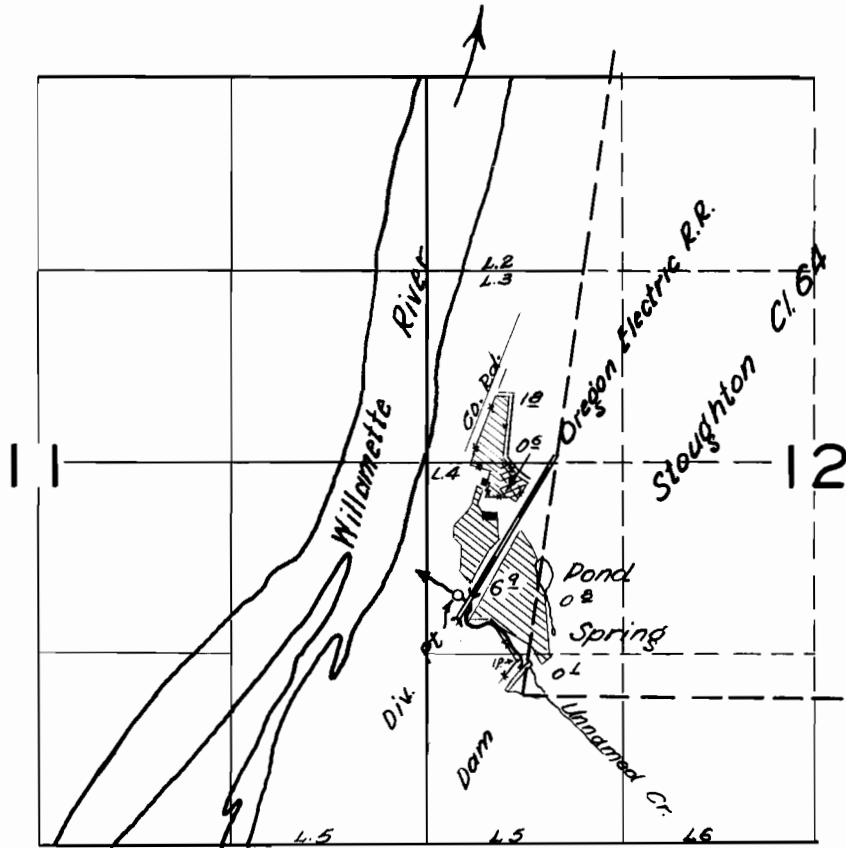

FINAL PROOF SURVEY

UNDER

Application No. 10004 Permit No. 16600

IN NAME OF

Surveyed Sept. 20 1952, by [Name] D.F.C. [Name]