


T. I. N. R. 2 E. W. M

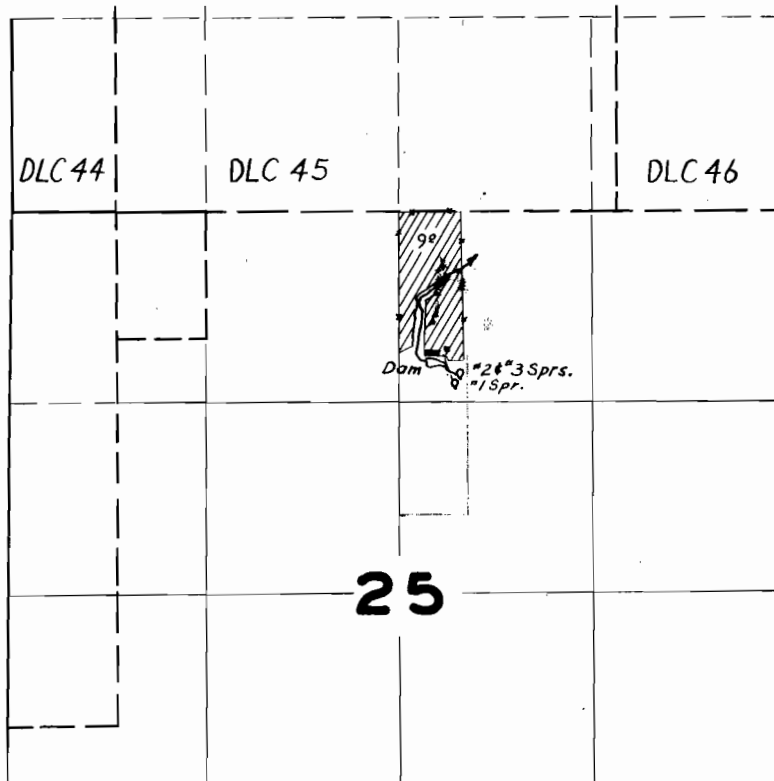

FINAL PROOF SURVEY

UNDER

Application No. 19755 Permit No. 15341

IN NAME OF

WILLIAM JOY SMITH

Surveyed July 3 1953, by H. L. Coffman