


T.18S. R.47 E.W.M.

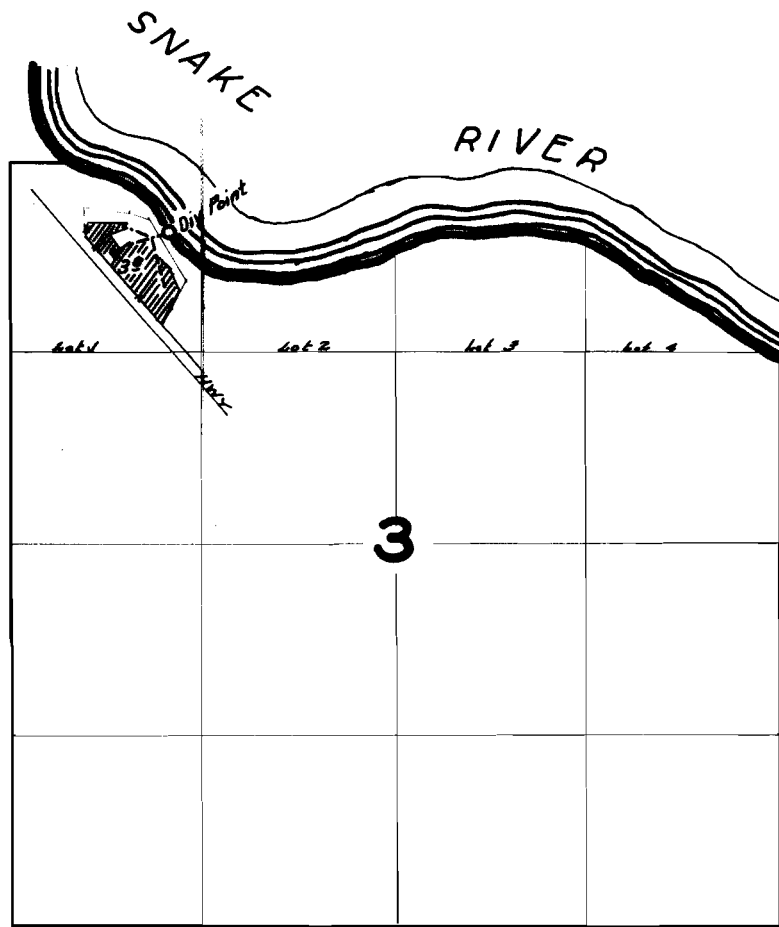

FINAL PROOF SURVEY

UNDER

Application No. 20145... Permit No. 156⁷59

IN NAME OF

ARTHUR E. PLANT

Surveyed 8/22 1951, by H.L. COFFMAN