


# T. 2 S. R. 1 E. W. M.

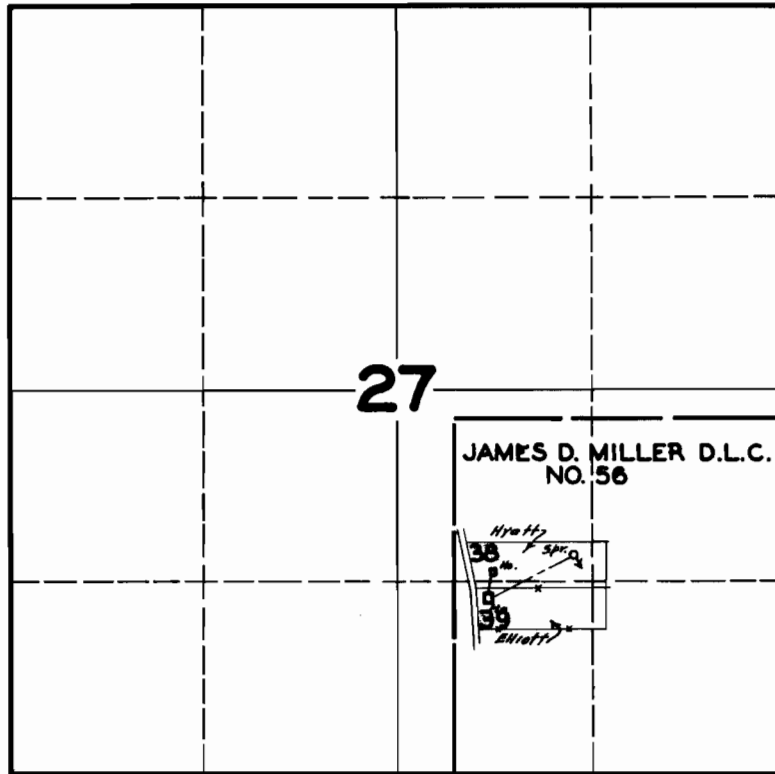

## FINAL PROOF SURVEY UNDER

Application No. 20496 Permit No. 16000

IN NAME OF

M. L. HYATT & CHAS. M. ELLIOTT

Surveyed JUN. 20 1947, by JAS. E. BUNNELL