


T.2&3N.R.27&28 E.W.M.

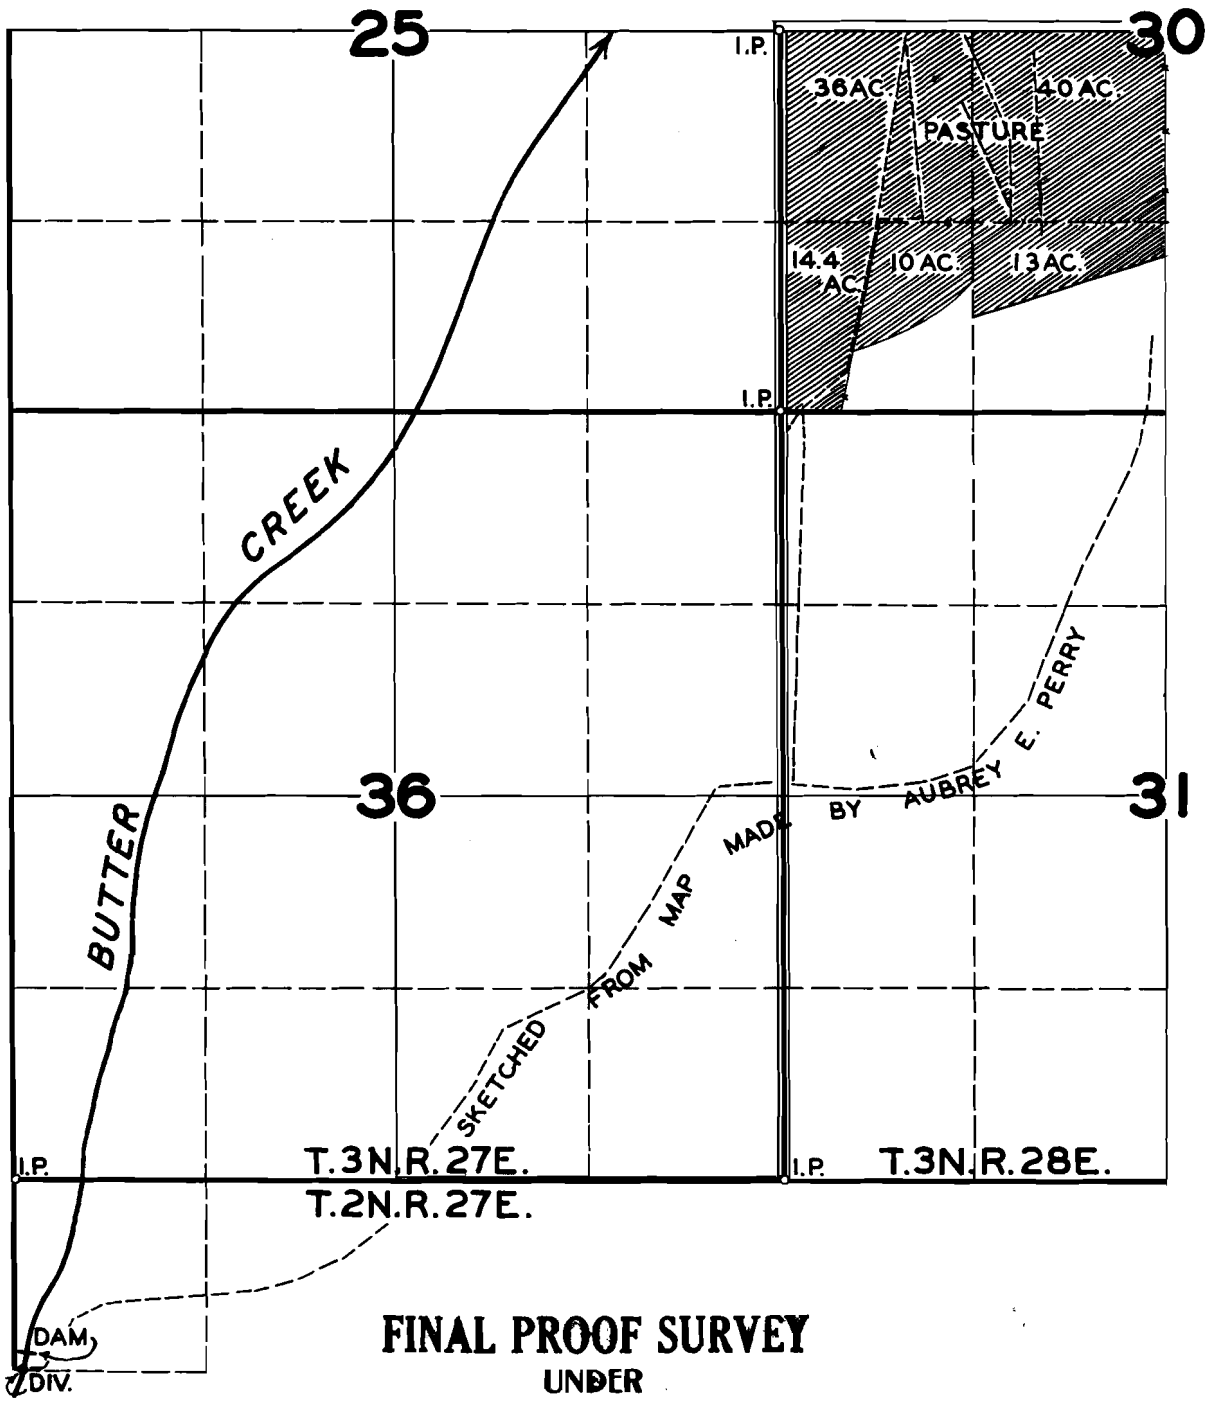

**FINAL PROOF SURVEY**  
UNDER

Application No. 20625 Permit No. 16132

IN NAME OF

RALPH G. SAYLOR

Surveyed APR. 16 1946, by JAS. E. BUNNELL