


T. 3 S. R. 2 E. W. M.

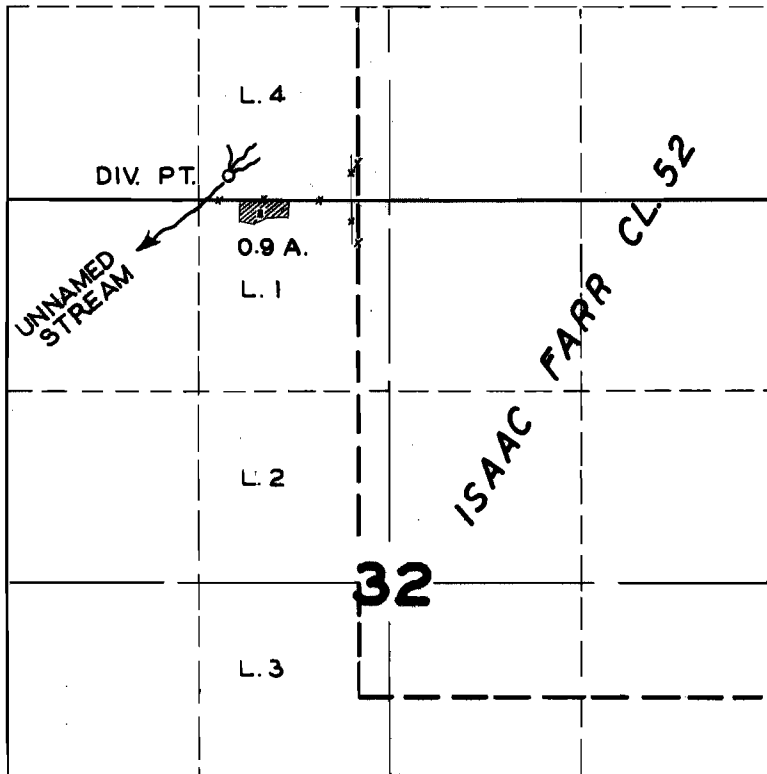

FINAL PROOF SURVEY
UNDER

Application No. 21067 Permit No. 16510
IN NAME OF

E.L. WILMOT & GRACE WILMOT

Surveyed APR 25 1950, by H.L. COFFMAN