


T.6S.R.10W.W.M.

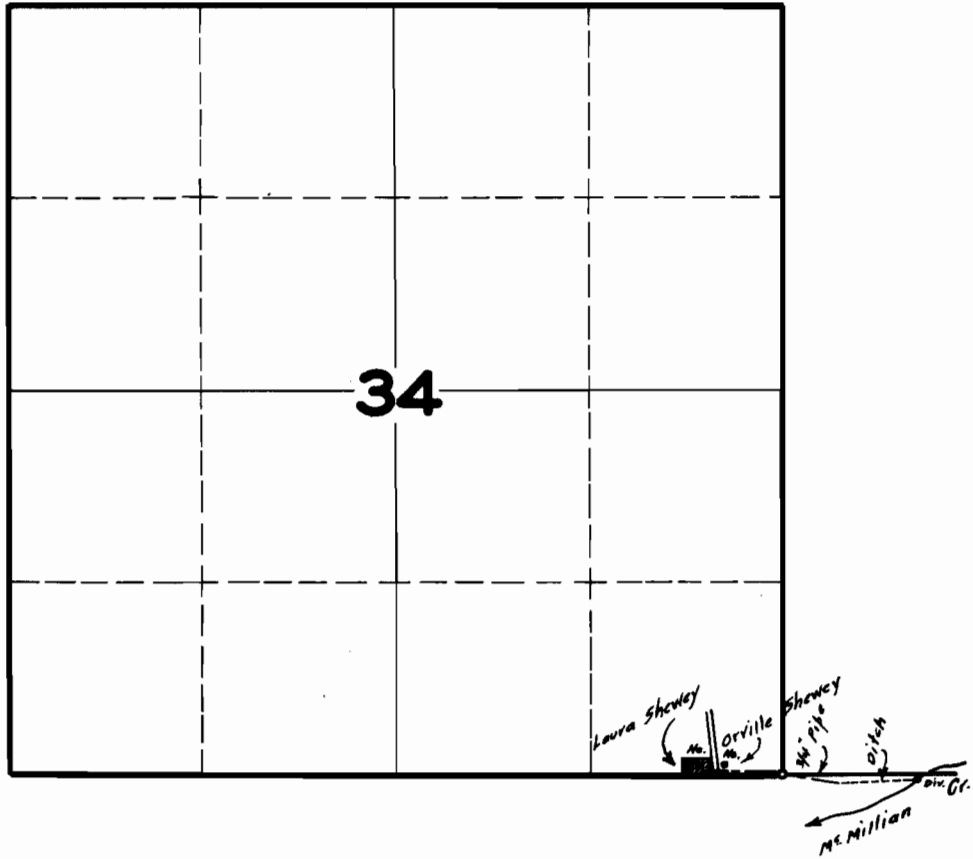

FINAL PROOF SURVEY
UNDER

Application No. 21543 Permit No. 16893

IN NAME OF

MRS. LAURA PEARL SHEWEY

Surveyed SEP. 10, 1946, by W. B. Russell