


T. 5S. R. 6W. WM

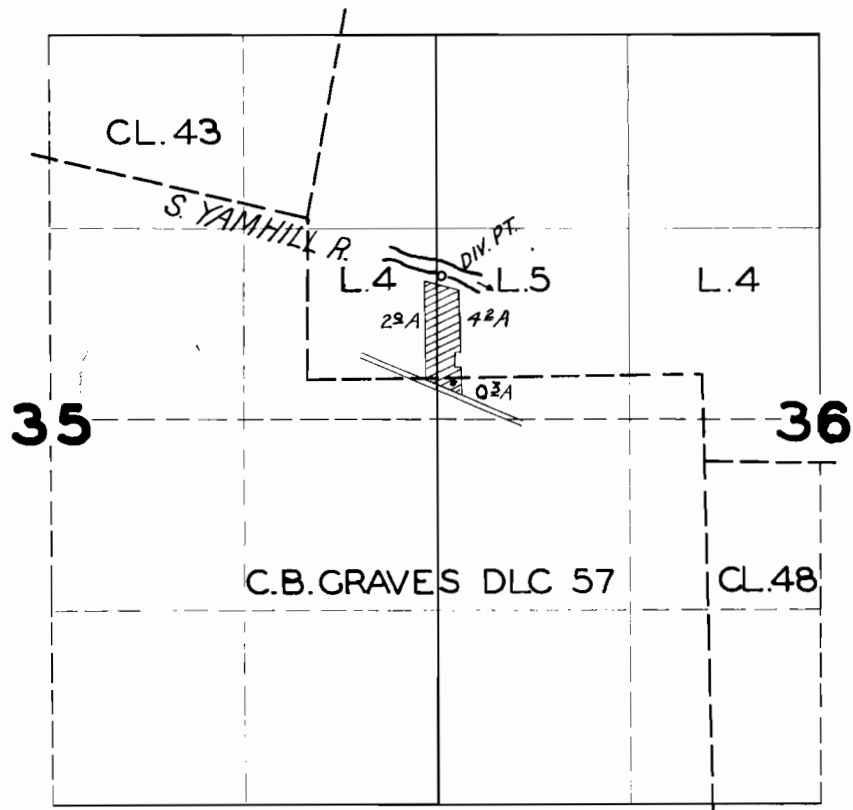

FINAL PROOF SURVEY

UNDER

Application No. 22356 Permit No. 17625

IN NAME OF

W. M. FAUL

Surveyed Sept. 27 19 51, by H. L. Coffman