


T.2N. R.10E.WM

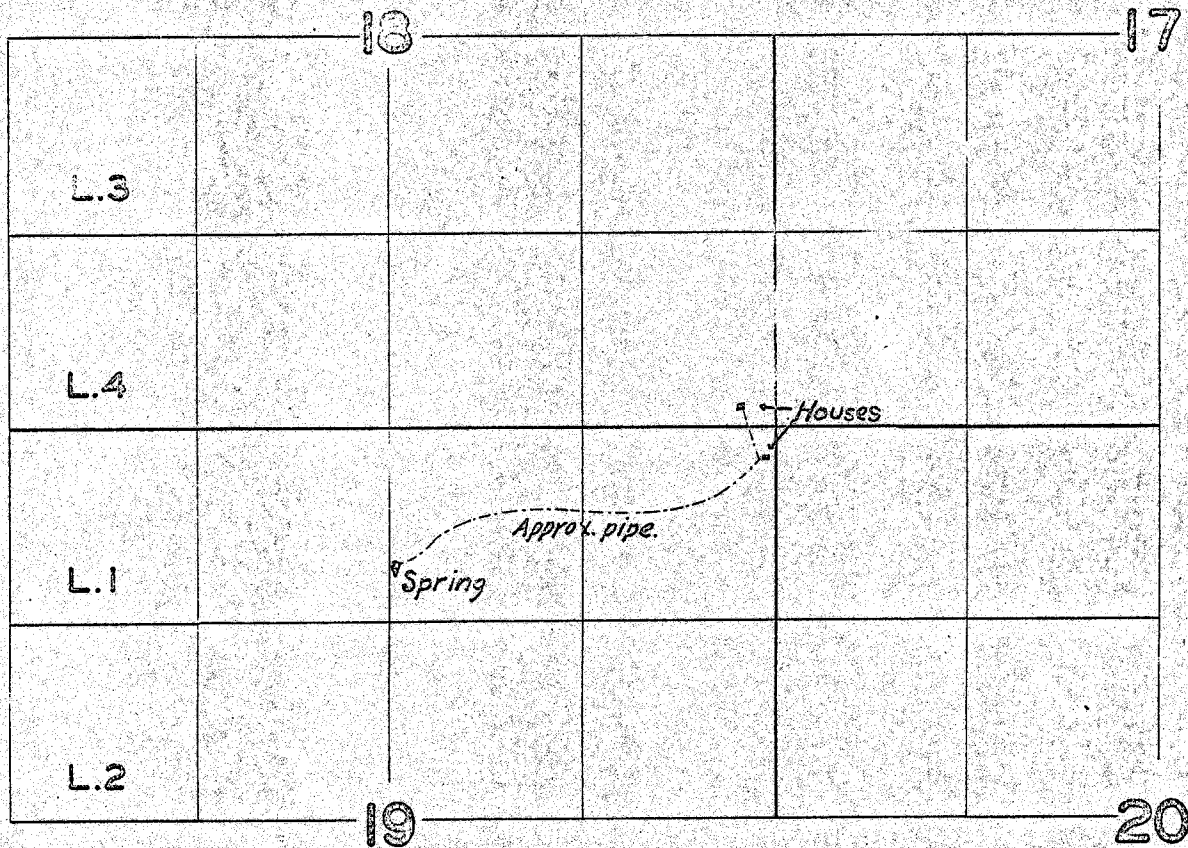

FINAL PROOF SUEVEY  
UNDER

Application No. 22872 Permit No. 17991

IN NAME OF

TOM HASEGAMI AND NOBUO KOBAYASHI

Surveyed June 12 19 53 by T. Jones