


T.26S.R.3W.WM

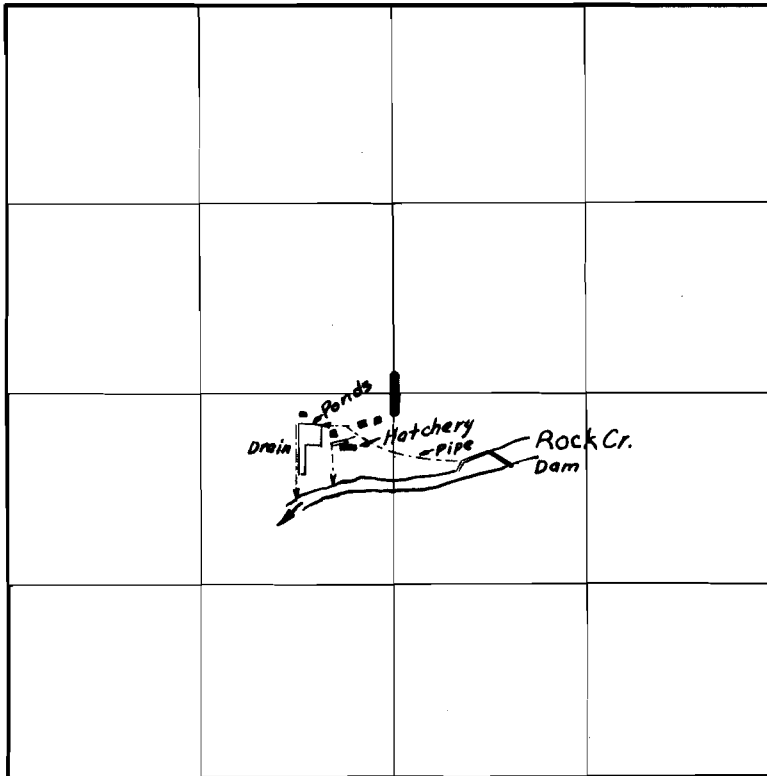

FINAL PROOF SURVEY

UNDER

Application No. 22447 Permit No. 17680

IN NAME OF

OREGON STATE GAME COMMISSION

Surveyed Sept. 2 1953, by H. L. Coffman