


T. 13 S. R. 1 E. W. M

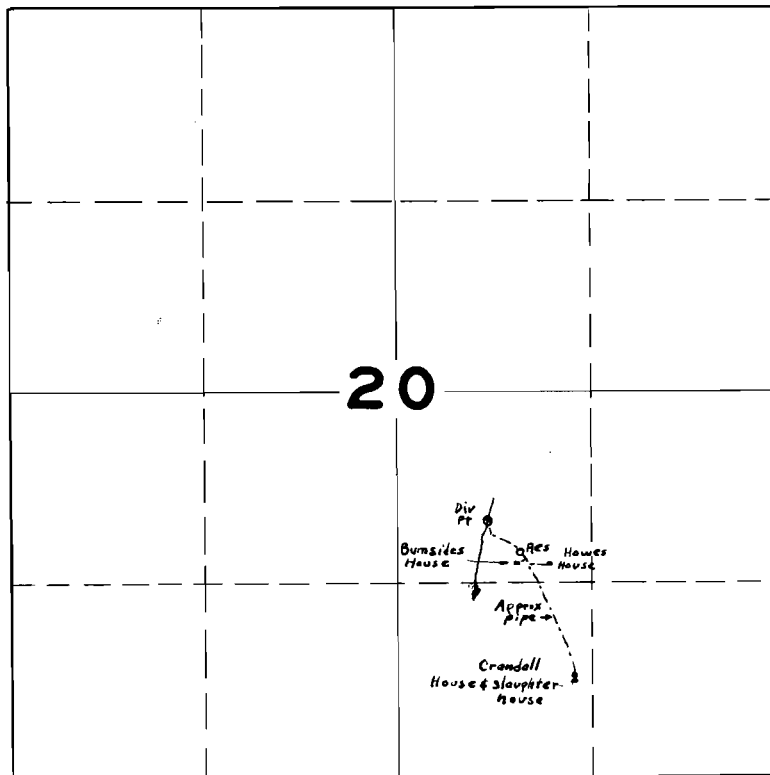

FINAL PROOF SURVEY
UNDER

Application No. 24262 Permit No. 19214
IN NAME OF

RAYMOND R. BURNSIDES - ELMER T. MC TIMMONDS

Surveyed Sept. 29 1953 by T. JONES