


T. 1S. R. 2W. WM

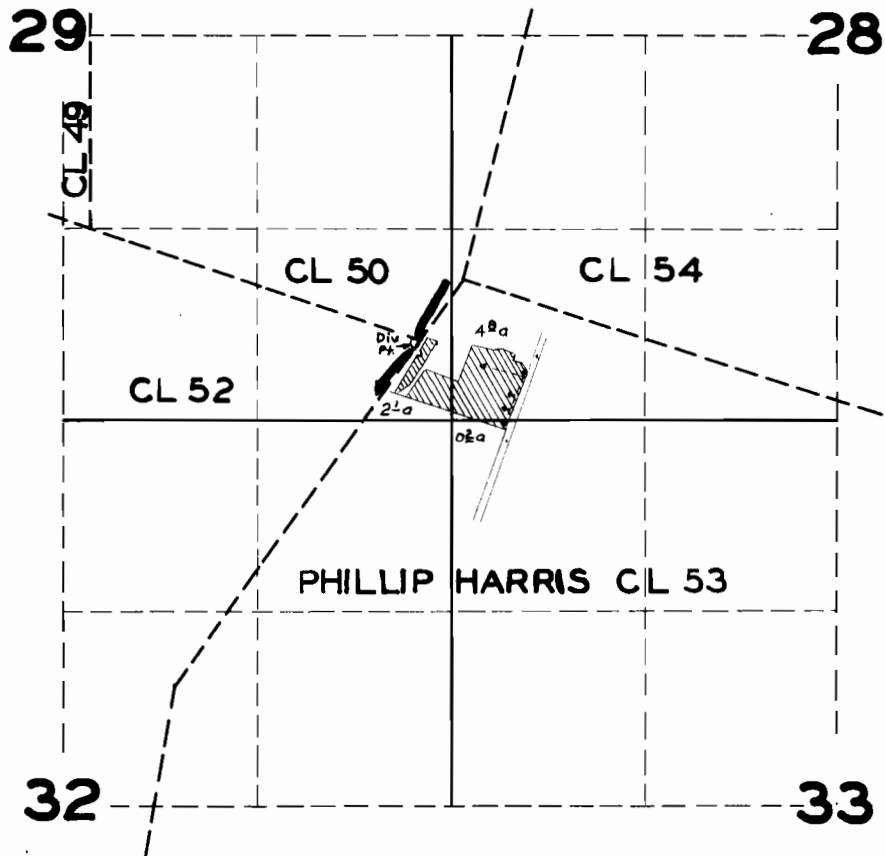

FINAL PROOF SURVEY

UNDER

Application No. 24961 Permit No. 19694

IN NAME OF

JOHN B. EHLER

Surveyed Apr. 7 19 53, by H. L. Coffman