
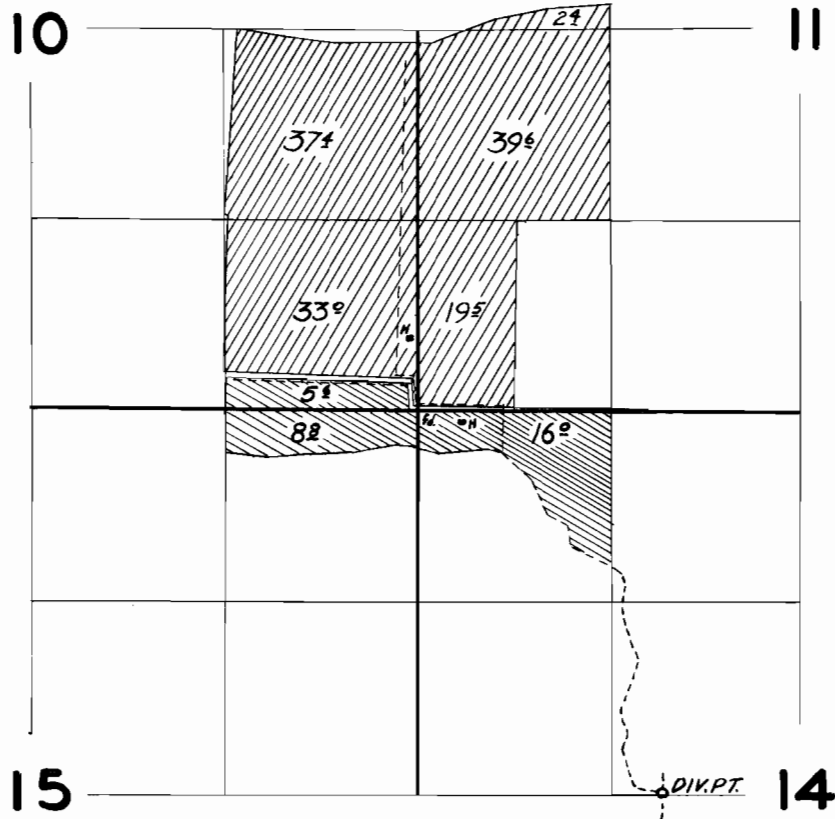



T.16S.R.47E.WM

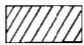

FINAL PROOF SURVEY

UNDER 17512 
 22273
 Application No. 22992 Permit No. 18133 
 IN NAME OF
 RAYMOND H. & RALPH E. BARKER
 Surveyed July 11, 1953, by J. Jones