
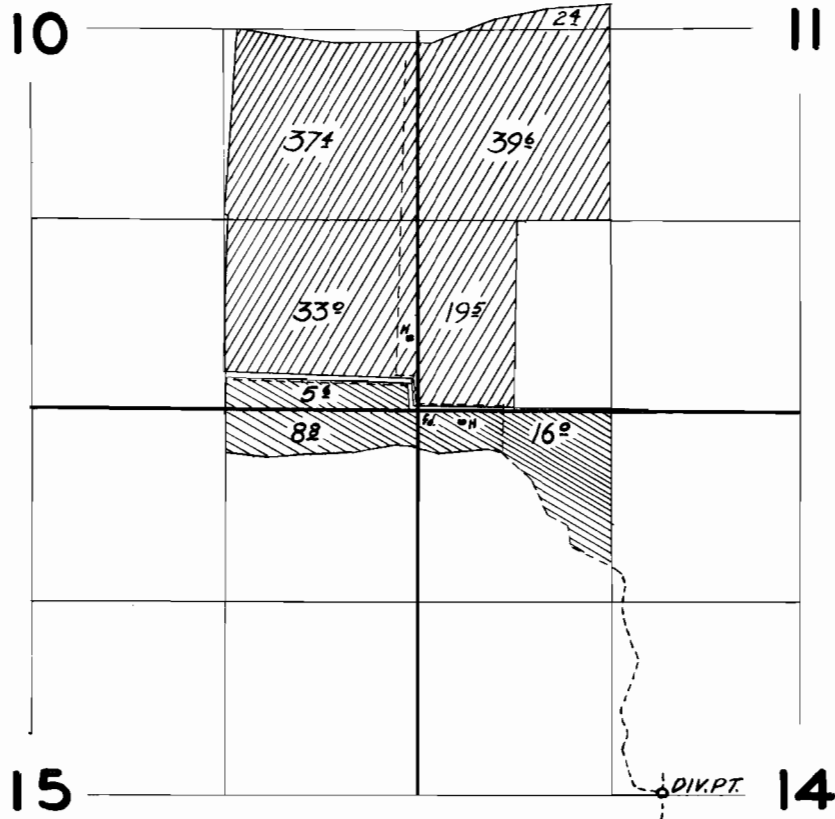



# T.16S.R.47E.WM

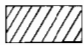

## FINAL PROOF SURVEY

UNDER 17512   
 22273  
 Application No. 22992 Permit No. 18133   
 IN NAME OF  
 RAYMOND H. & RALPH E. BARKER  
 Surveyed July 11, 1953, by J. Jones