


T.18S.R.46&47E.WM

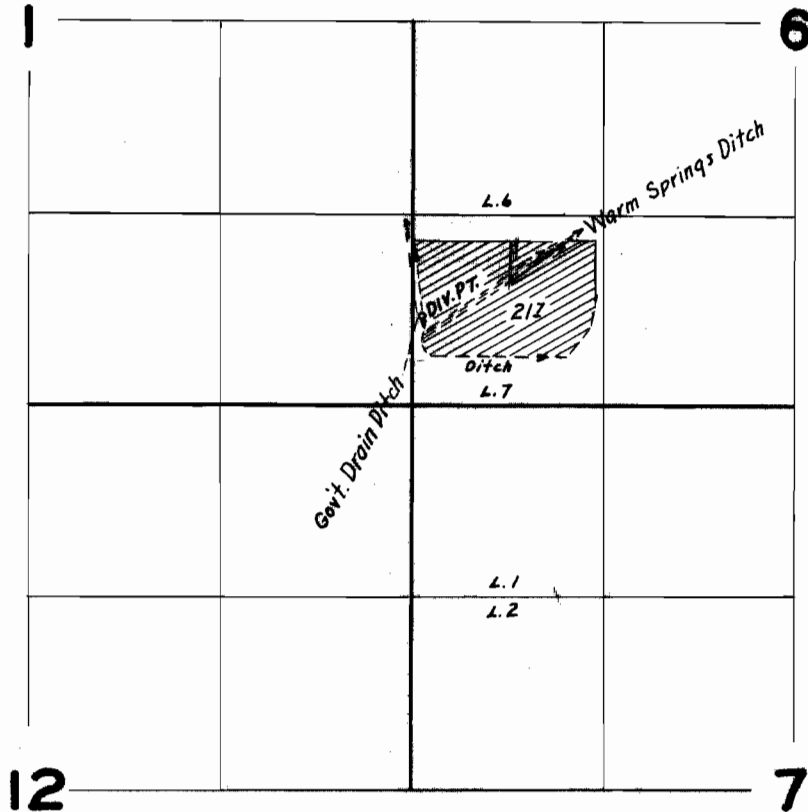

FINAL PROOF SURVEY UNDER

Application No. 21033 Permit No. 17387
IN NAME OF

H.L. Silkett

Surveyed July 23 1953, by H.L. Hoffman