


T.2S.R.1 W.W.M.

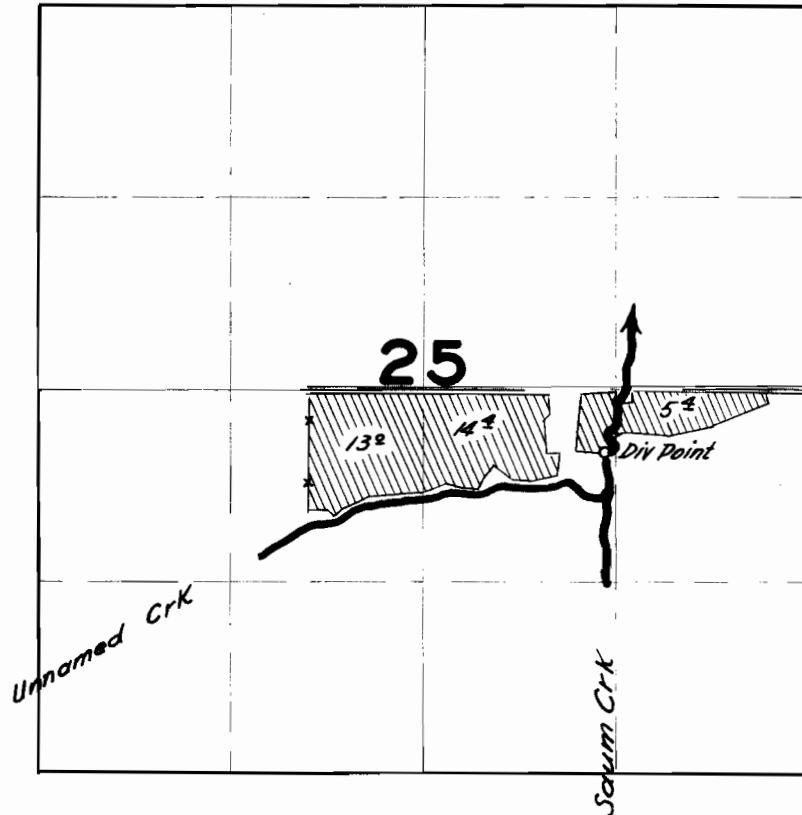

FINAL PROOF SURVEY

UNDER

Application No. 25039 Permit No. 19944

IN NAME OF

VICTOR CHRISTENSEN

Surveyed April 6 1953, by H. L. Coffman