


# T.I.N.R. 2 W.W.M.

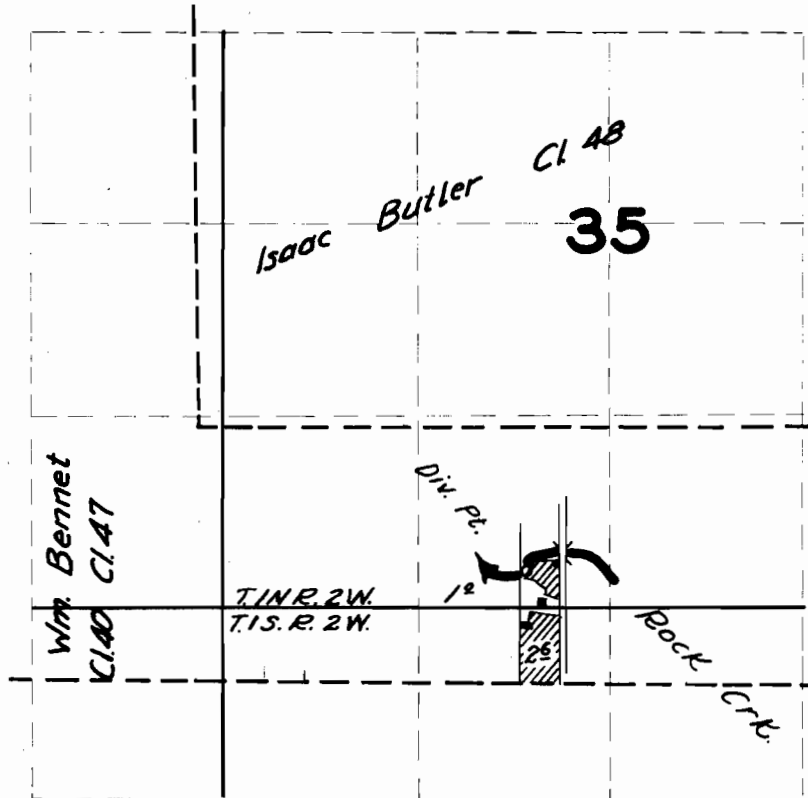

## FINAL PROOF SURVEY

UNDER

Application No. 26694 Permit No. 20897

IN NAME OF

CLARENCE E. & MARIE K. HAINES

Surveyed Apr. 3 19 53, by H. L. Coffman