


T. IS. R. IW. WM

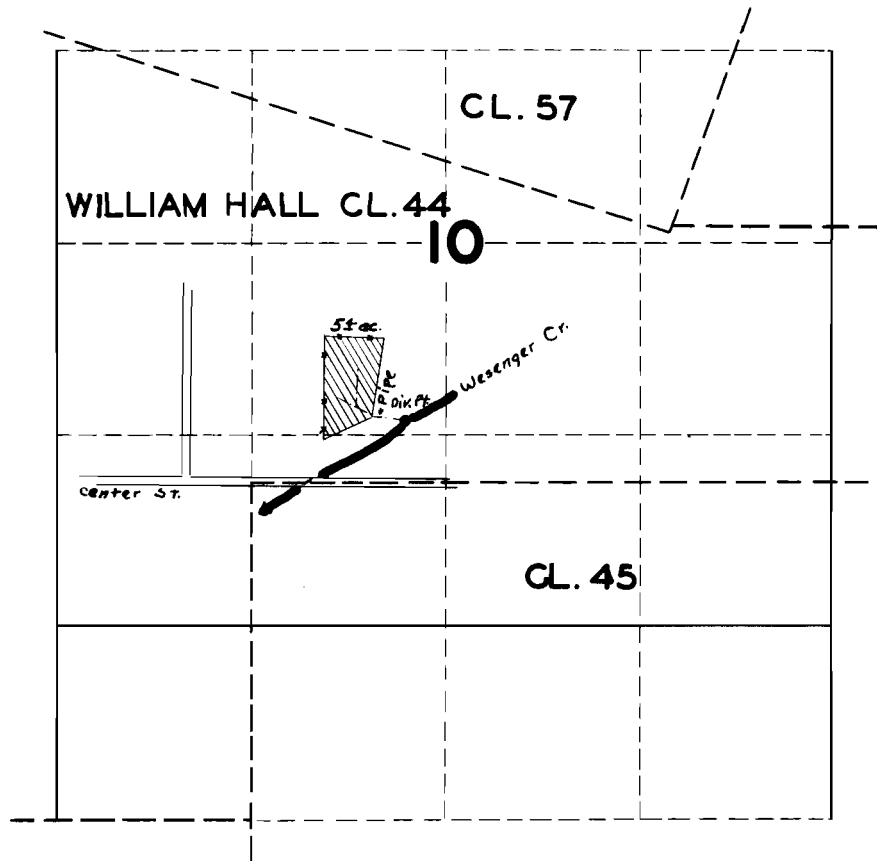

FINAL PROOF SURVEY

UNDER

Application No. 26727 Permit No. 20917

IN NAME OF

JOSEPH RUCEK

Surveyed Apr. 3 1953, by H. S. Coffman