


T.30S. R.4W. WM

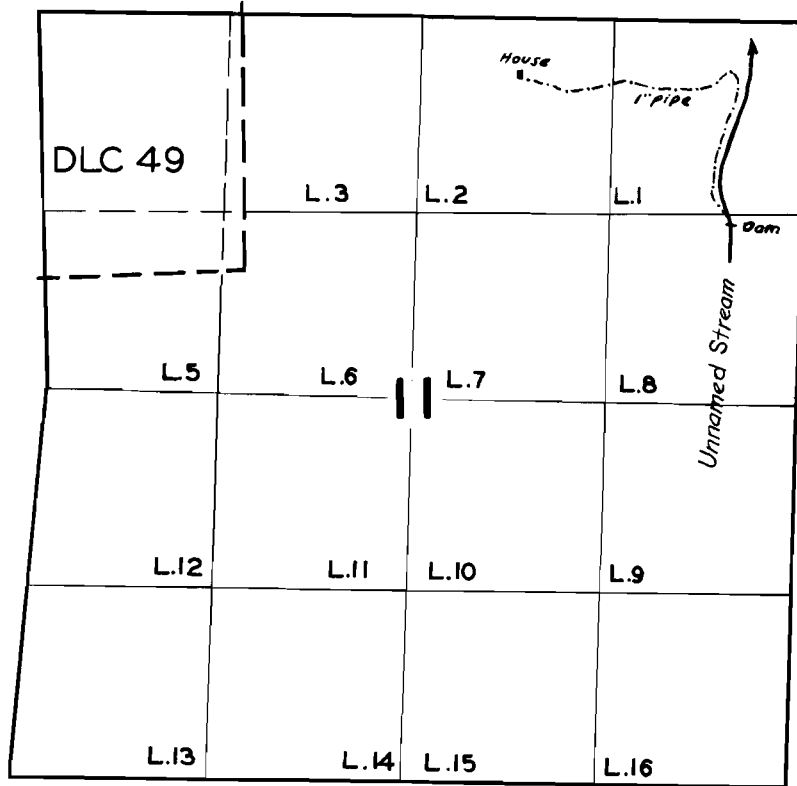

FINAL PROOF SURVEY

UNDER

Application No. 22210 Permit No. 17536

IN NAME OF

FRANK RACHOR

Surveyed May 24 1950, by H. L. Coffman