


T. I. S. R. I. W. W. M

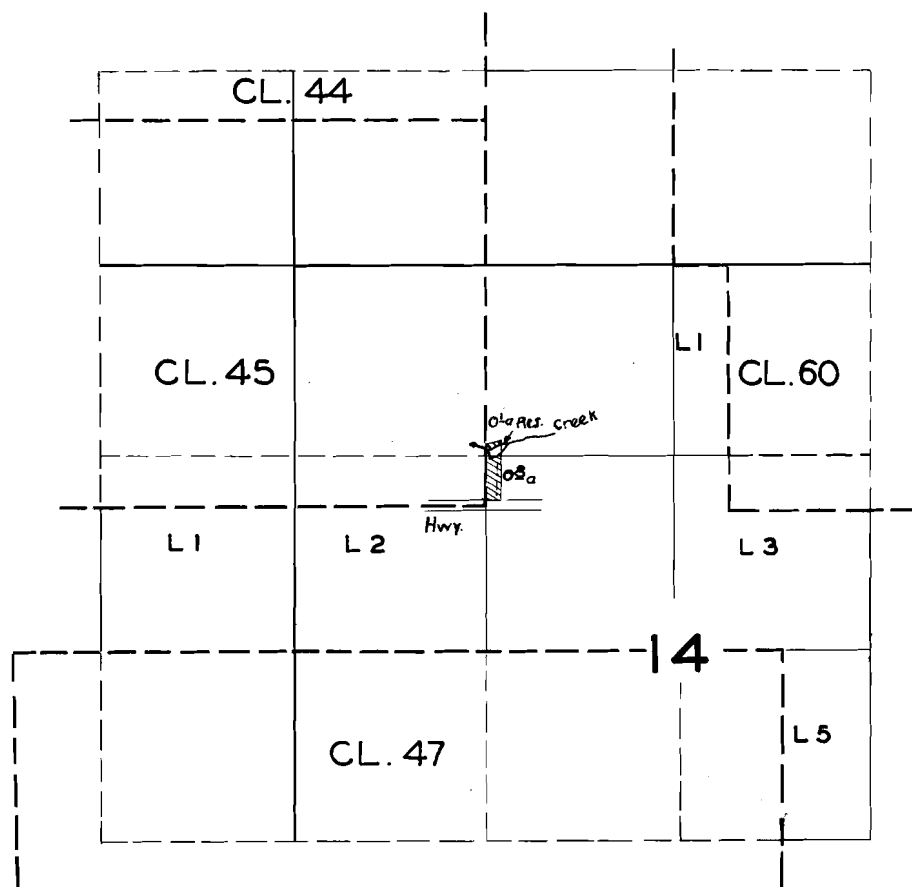

FINAL PROOF SURVEY UNDER

Application No. 26783 Permit No. 21042

IN NAME OF

B. E. TORPEN

Surveyed Apr. 8 1953, by H. L. Coffman