


North

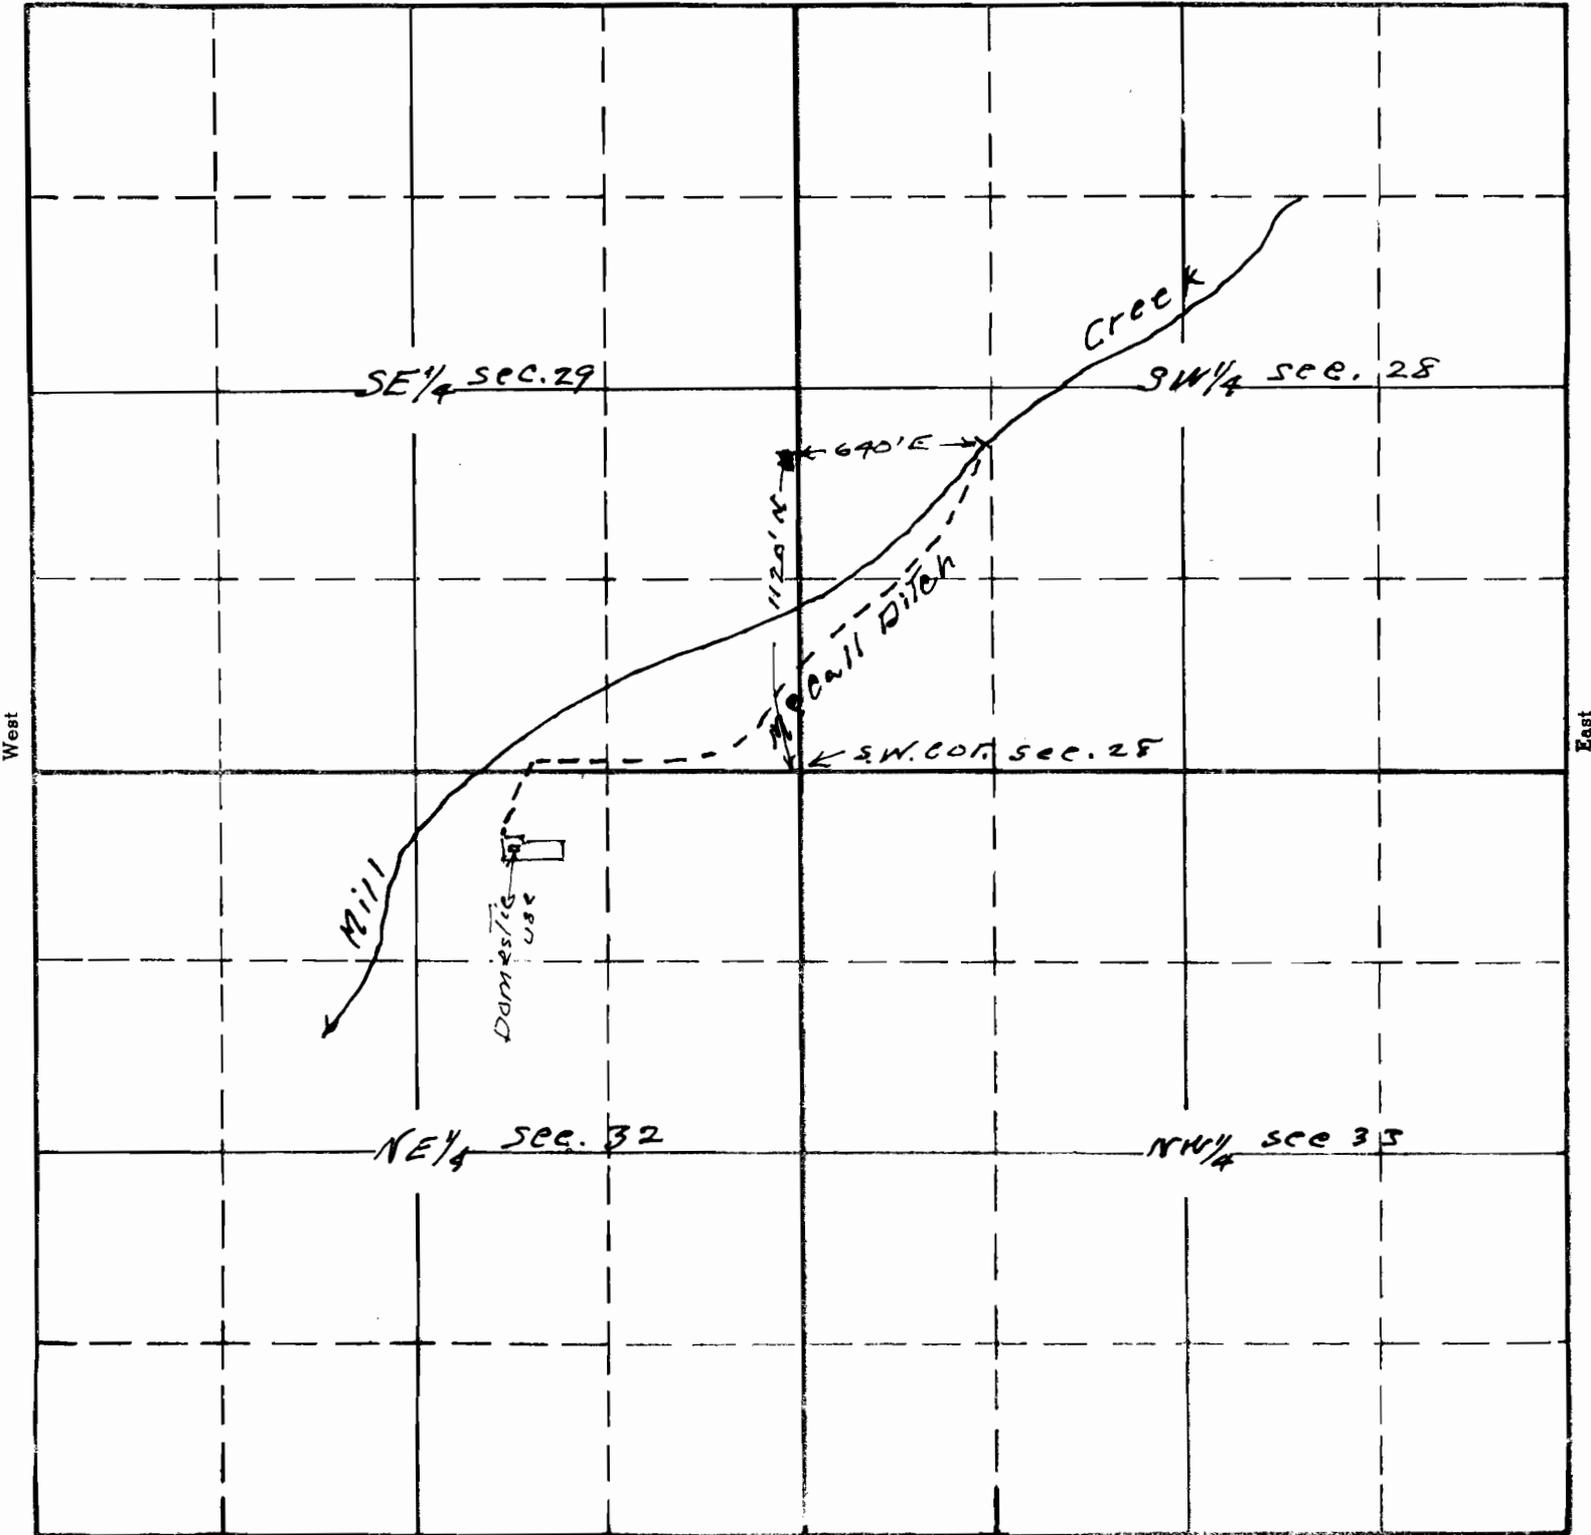

South

Map to accompany application of  
 Stephen A Moore  
 for change in character of use from  
 irrigation to domestic purposes

APPLICATION No.  
 PERMIT No.

This office 3/20/45 *EVH/WH*