


T.36S.R.11E.WM

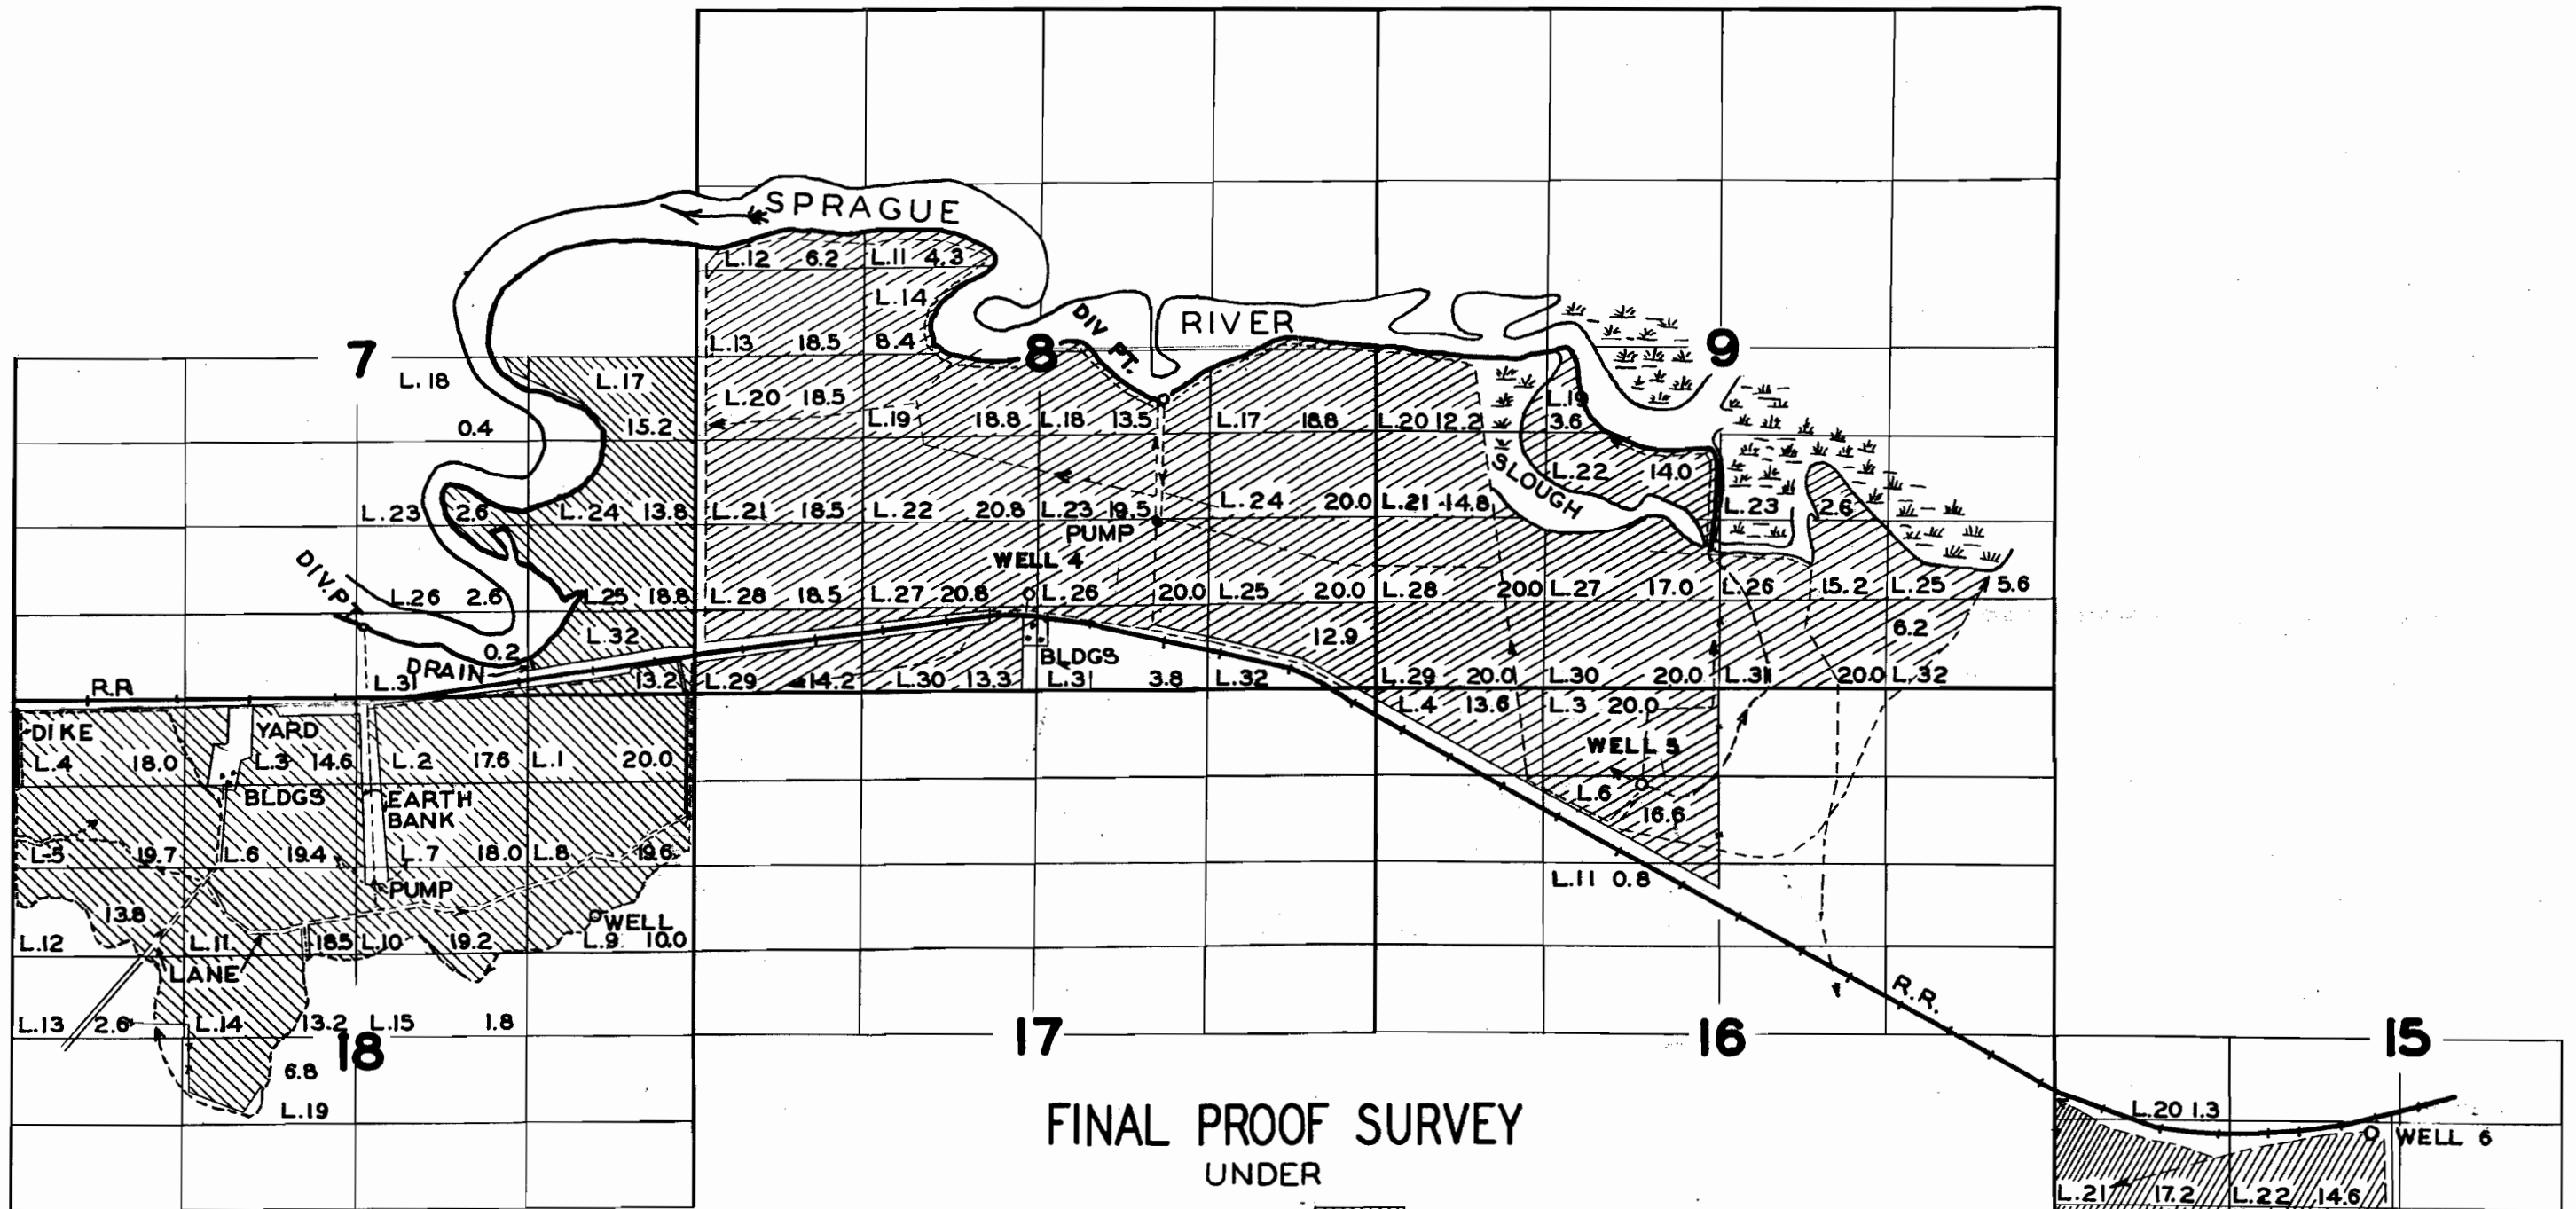

FINAL PROOF SURVEY UNDER

U-244		U-254
APPLICATION NO. 25643		PERMIT NO. 21236
U-585		U-534

IN NAME OF

D.M.Hess Frank & Virginia Goularte

SURVEYED AUG. 18 & 19, 1953, BY H. L. COFFMAN