


T.38S.R.11 1/2 E.WM

Buck Cr. & Yema Valley Well

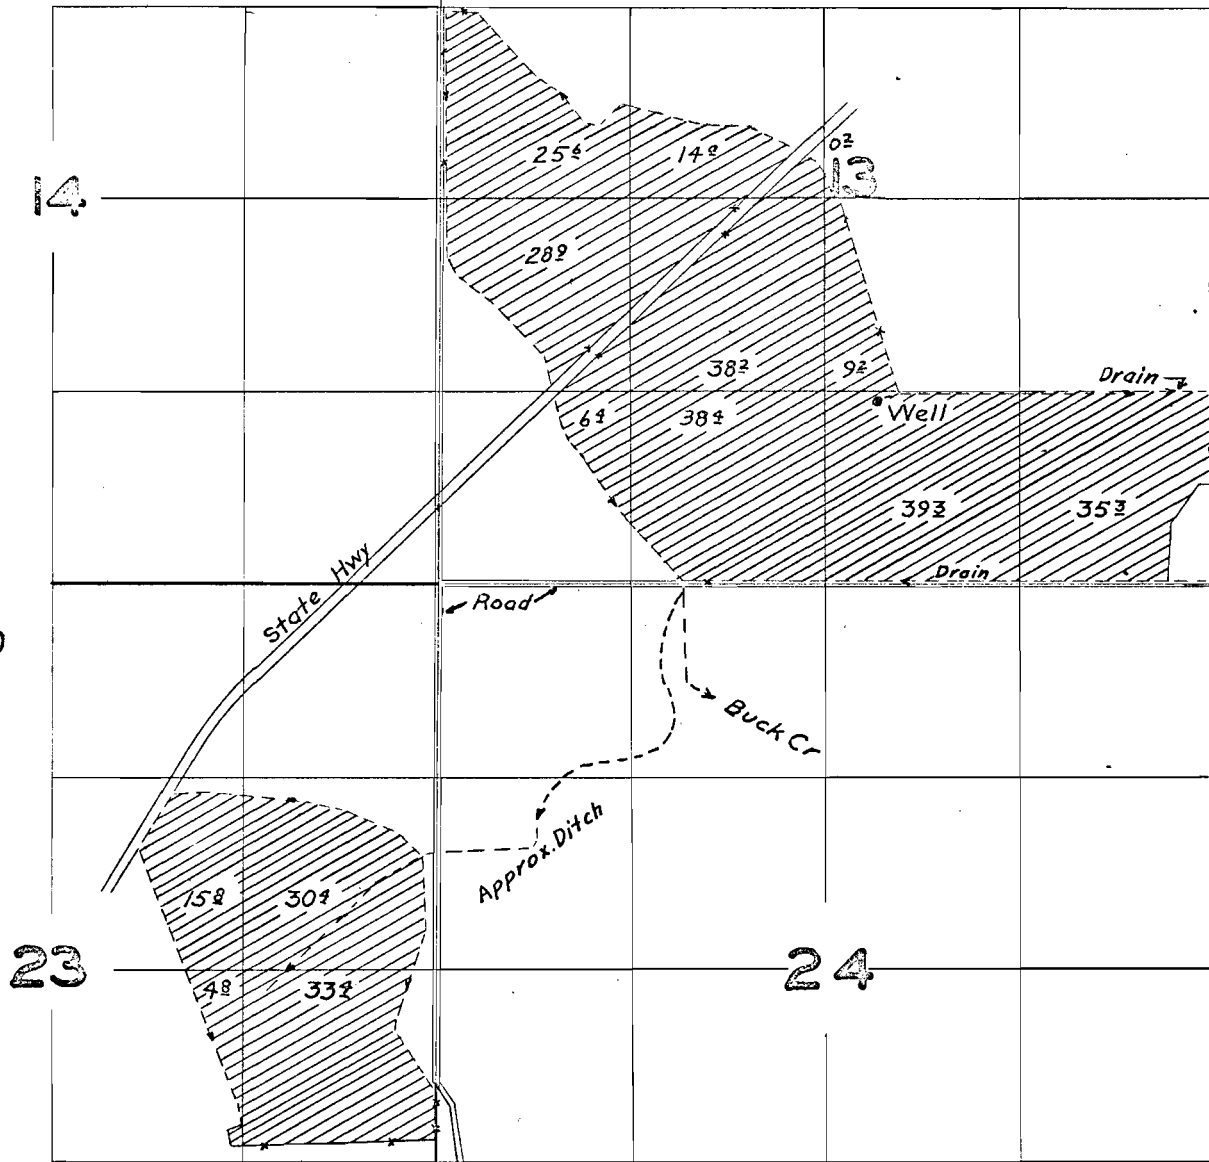

FINAL PROOF SURVEY

UNDER

Application No. U-218 Permit No. U-225

IN NAME OF

W. W. Koenig

Surveyed Aug. 10, 1953, by J. Jones