


# T.38S.R.11 1/2 E.WM

Buck Creek; Yonna Valley wells

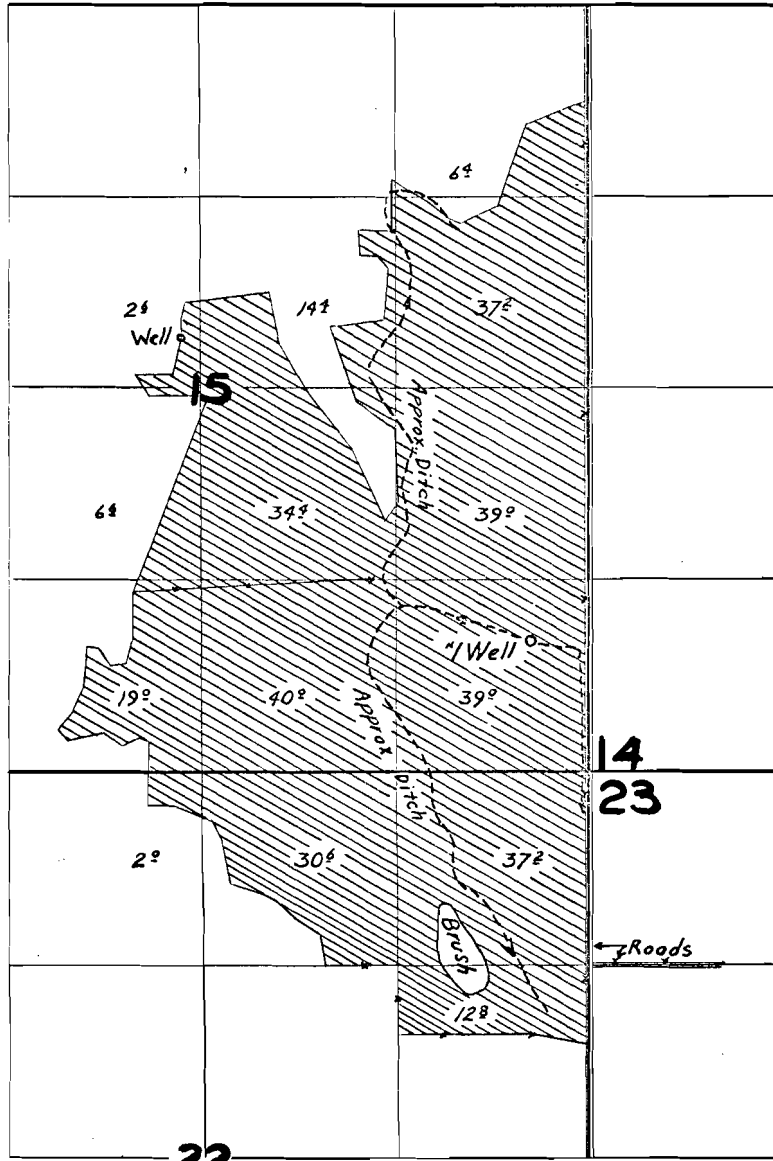

## FINAL PROOF SURVEY UNDER

Application No. 1-263 Permit No. 3-237  
IN NAME OF

A. J. Thomas and Donald L. Thomas

Surveyed Aug. 22 1922, by A. J. Thomas