


T.15S.R.47E.WM

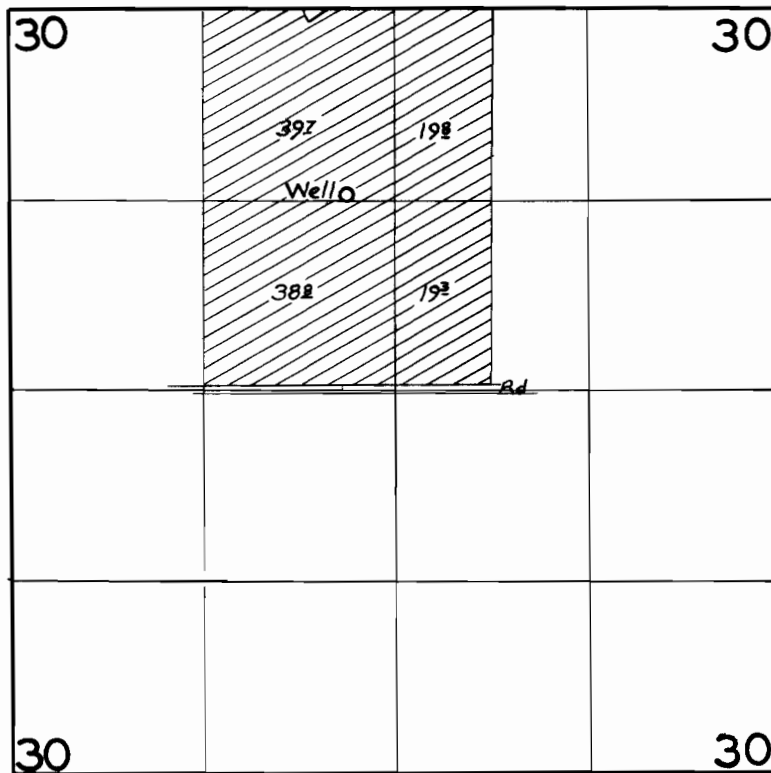

FINAL PROOF SURVEY

UNDER

Application No. U-291 Permit No. U-268

IN NAME OF

CLAIR L. GENTRY

Surveyed July 15 1953, by T. Jones