


T.18S.R.47E.WM

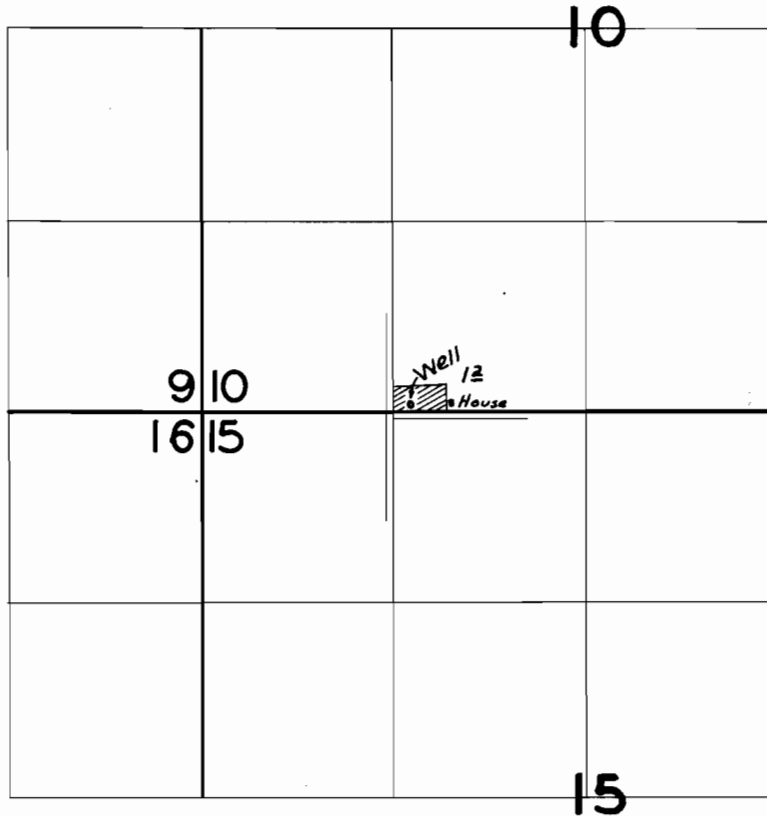

FINAL PROOF SURVEY

UNDER

Application No. U-301 Permit No. U-276

IN NAME OF

Carl Carver Carl Carver

Surveyed Feb 19 31, by