


Permit U-534

U-2:
21236

11 E.W.M

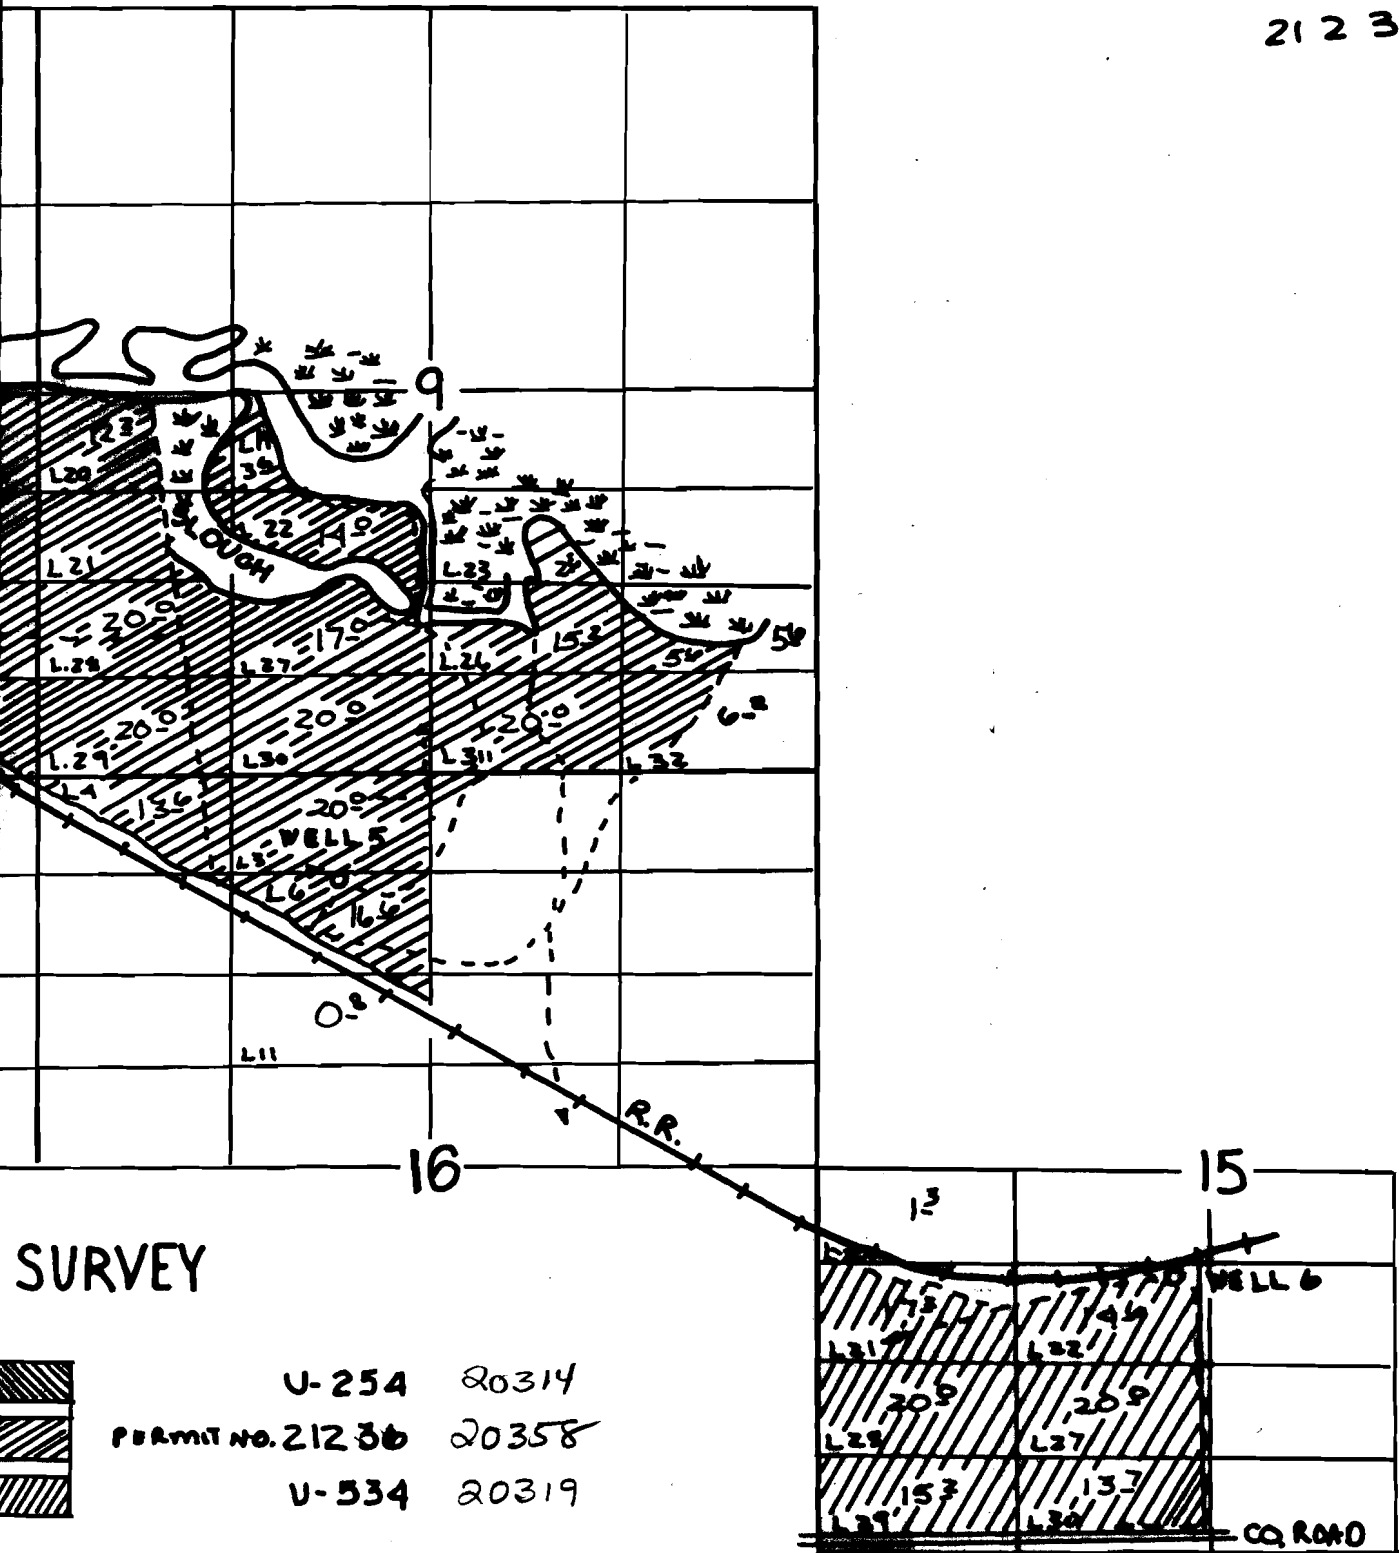


SURVEY



U-254	20314
PERMIT NO. 21236	20358
U-534	20319

Virginia Goularte

T.36 S. R

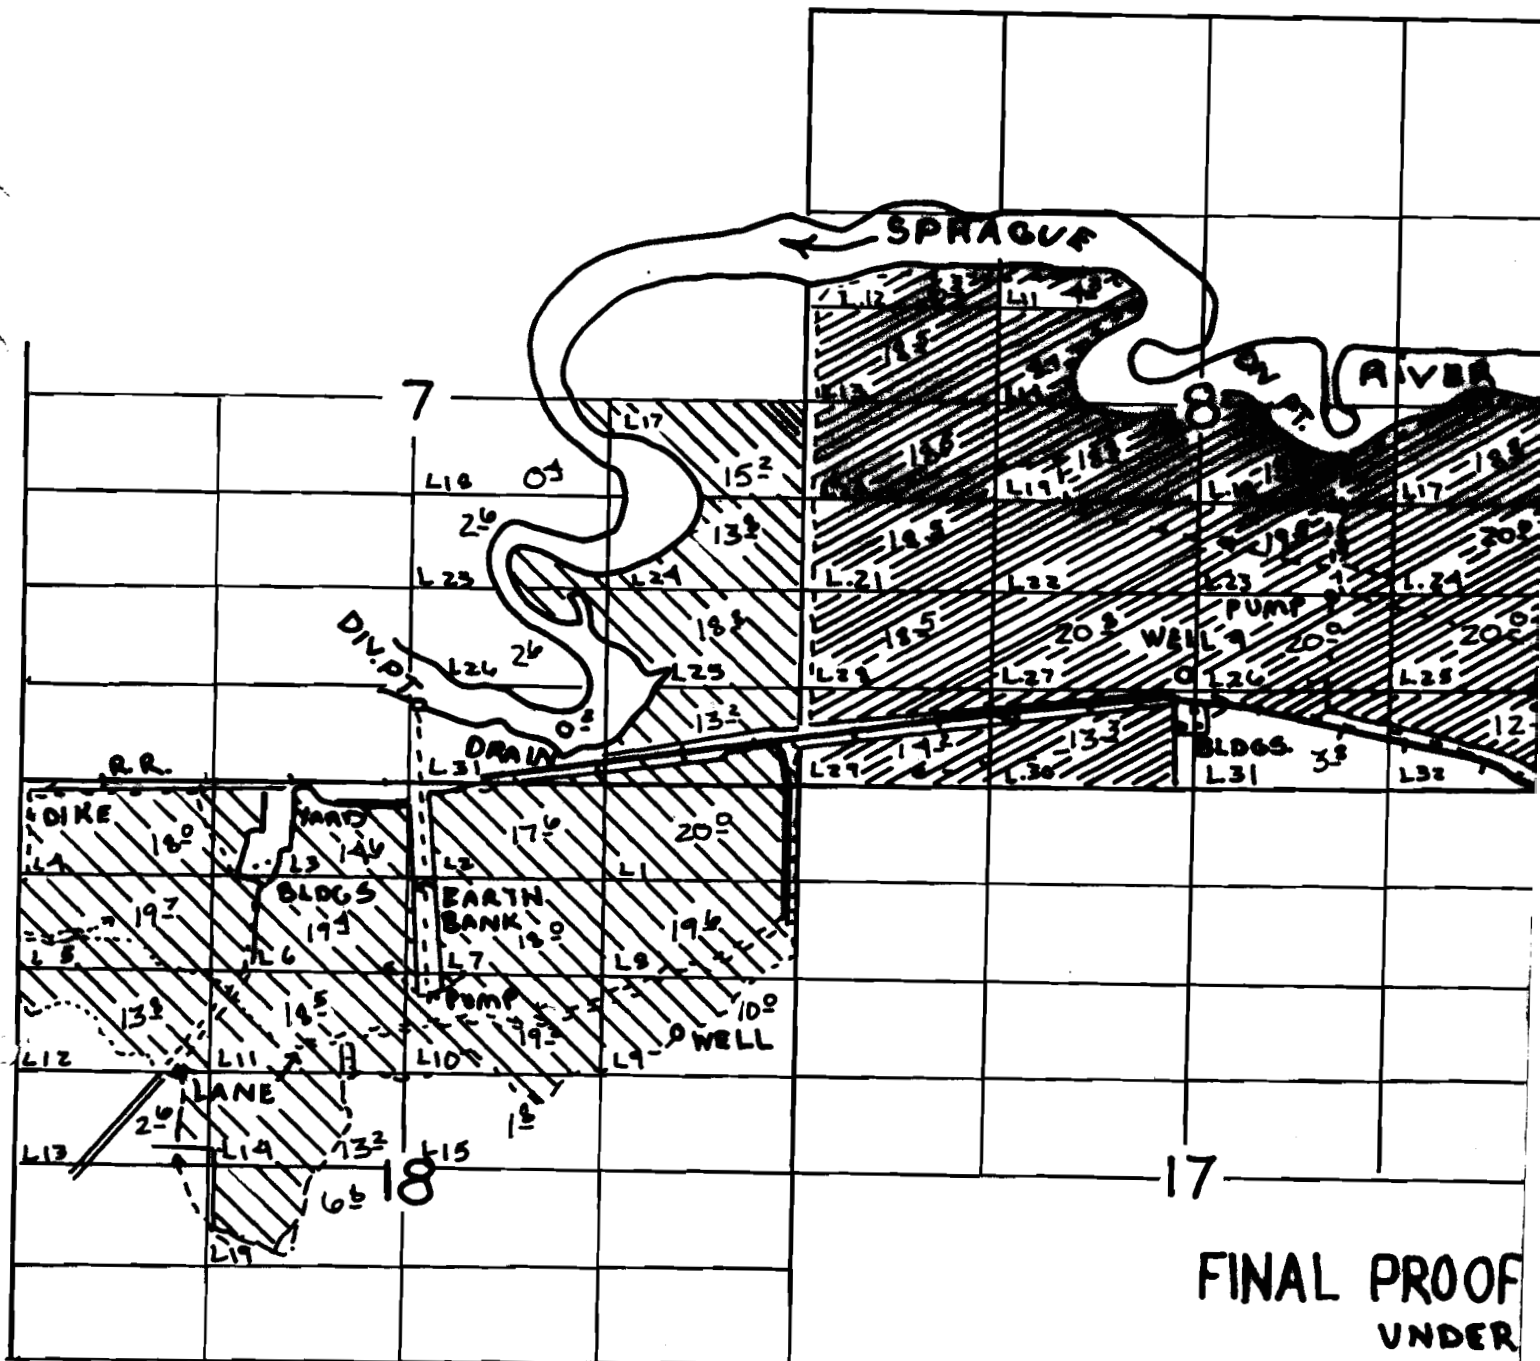

FINAL PROOF
UNDER

U-244
 APPLICATION NO. 25643
 U-585
 IN NAME OF
 D.M.Hess Frank &