


T.36 S. R.11 & 12 E WM

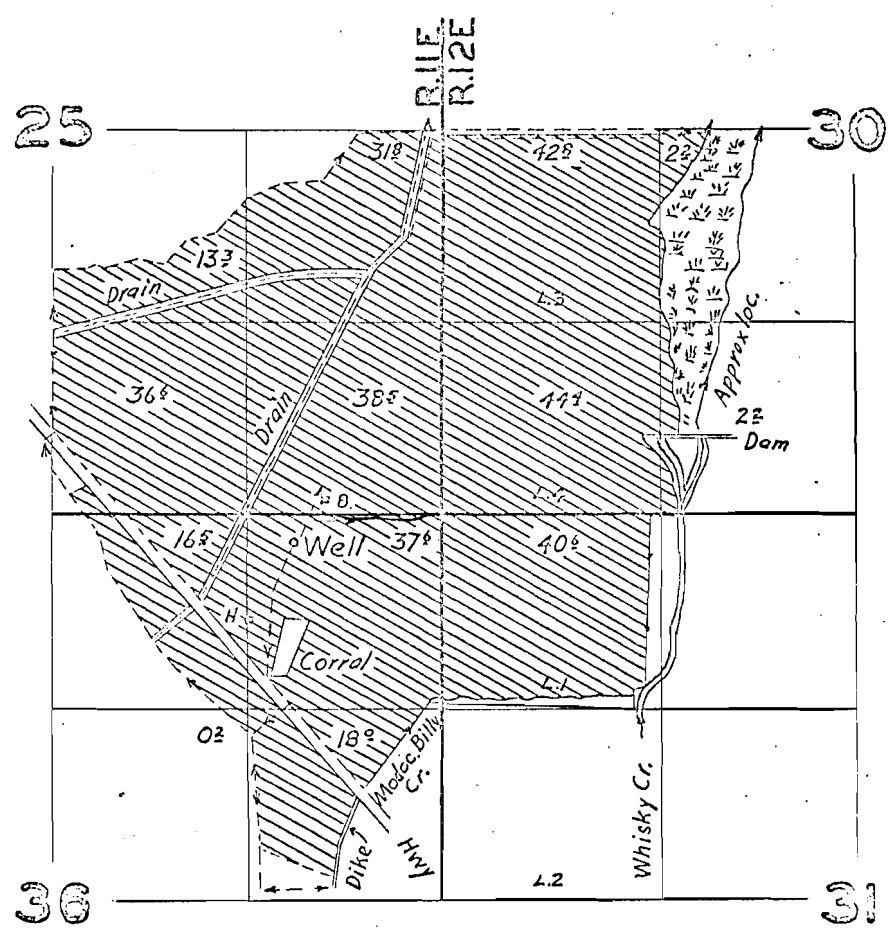

whiskey creek wells

FINAL PROOF SURVEY UNDER

Application No. U-315 Permit No. U-262
IN NAME OF

W. L. & Elizabeth H. Williams

Surveyed Aug 21 1952, by H. L. Collins