


T.5S.R.5W.W.M.

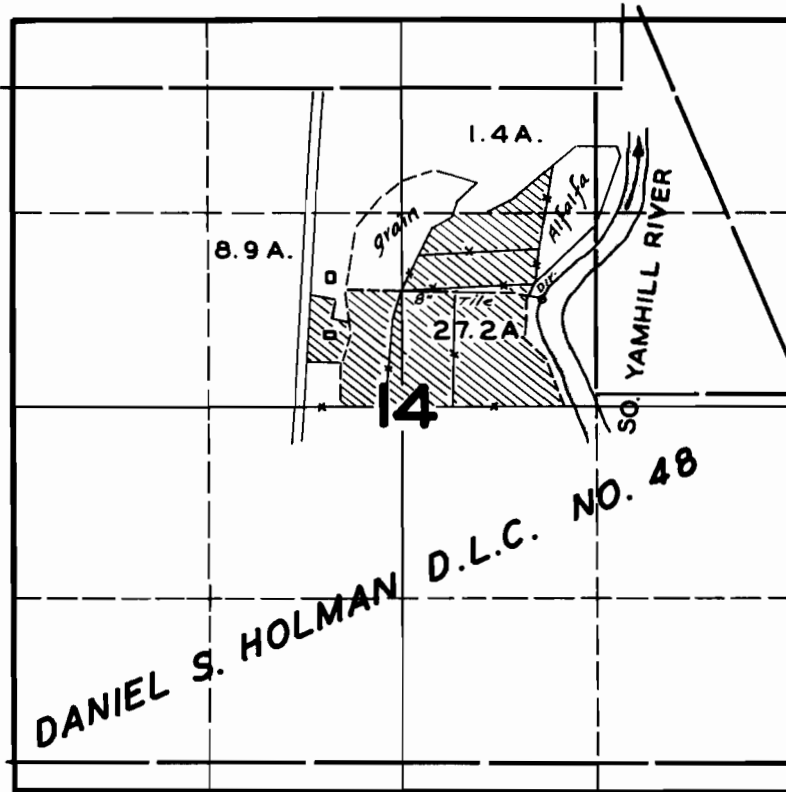

FINAL PROOF SURVEY

UNDER

Application No. **15559** Permit No. **11432**

IN NAME OF

S. V. & M. K. DRAGOO

Surveyed **MAR. 25 1947**, by **JAS. E. BUNNELL**