


17

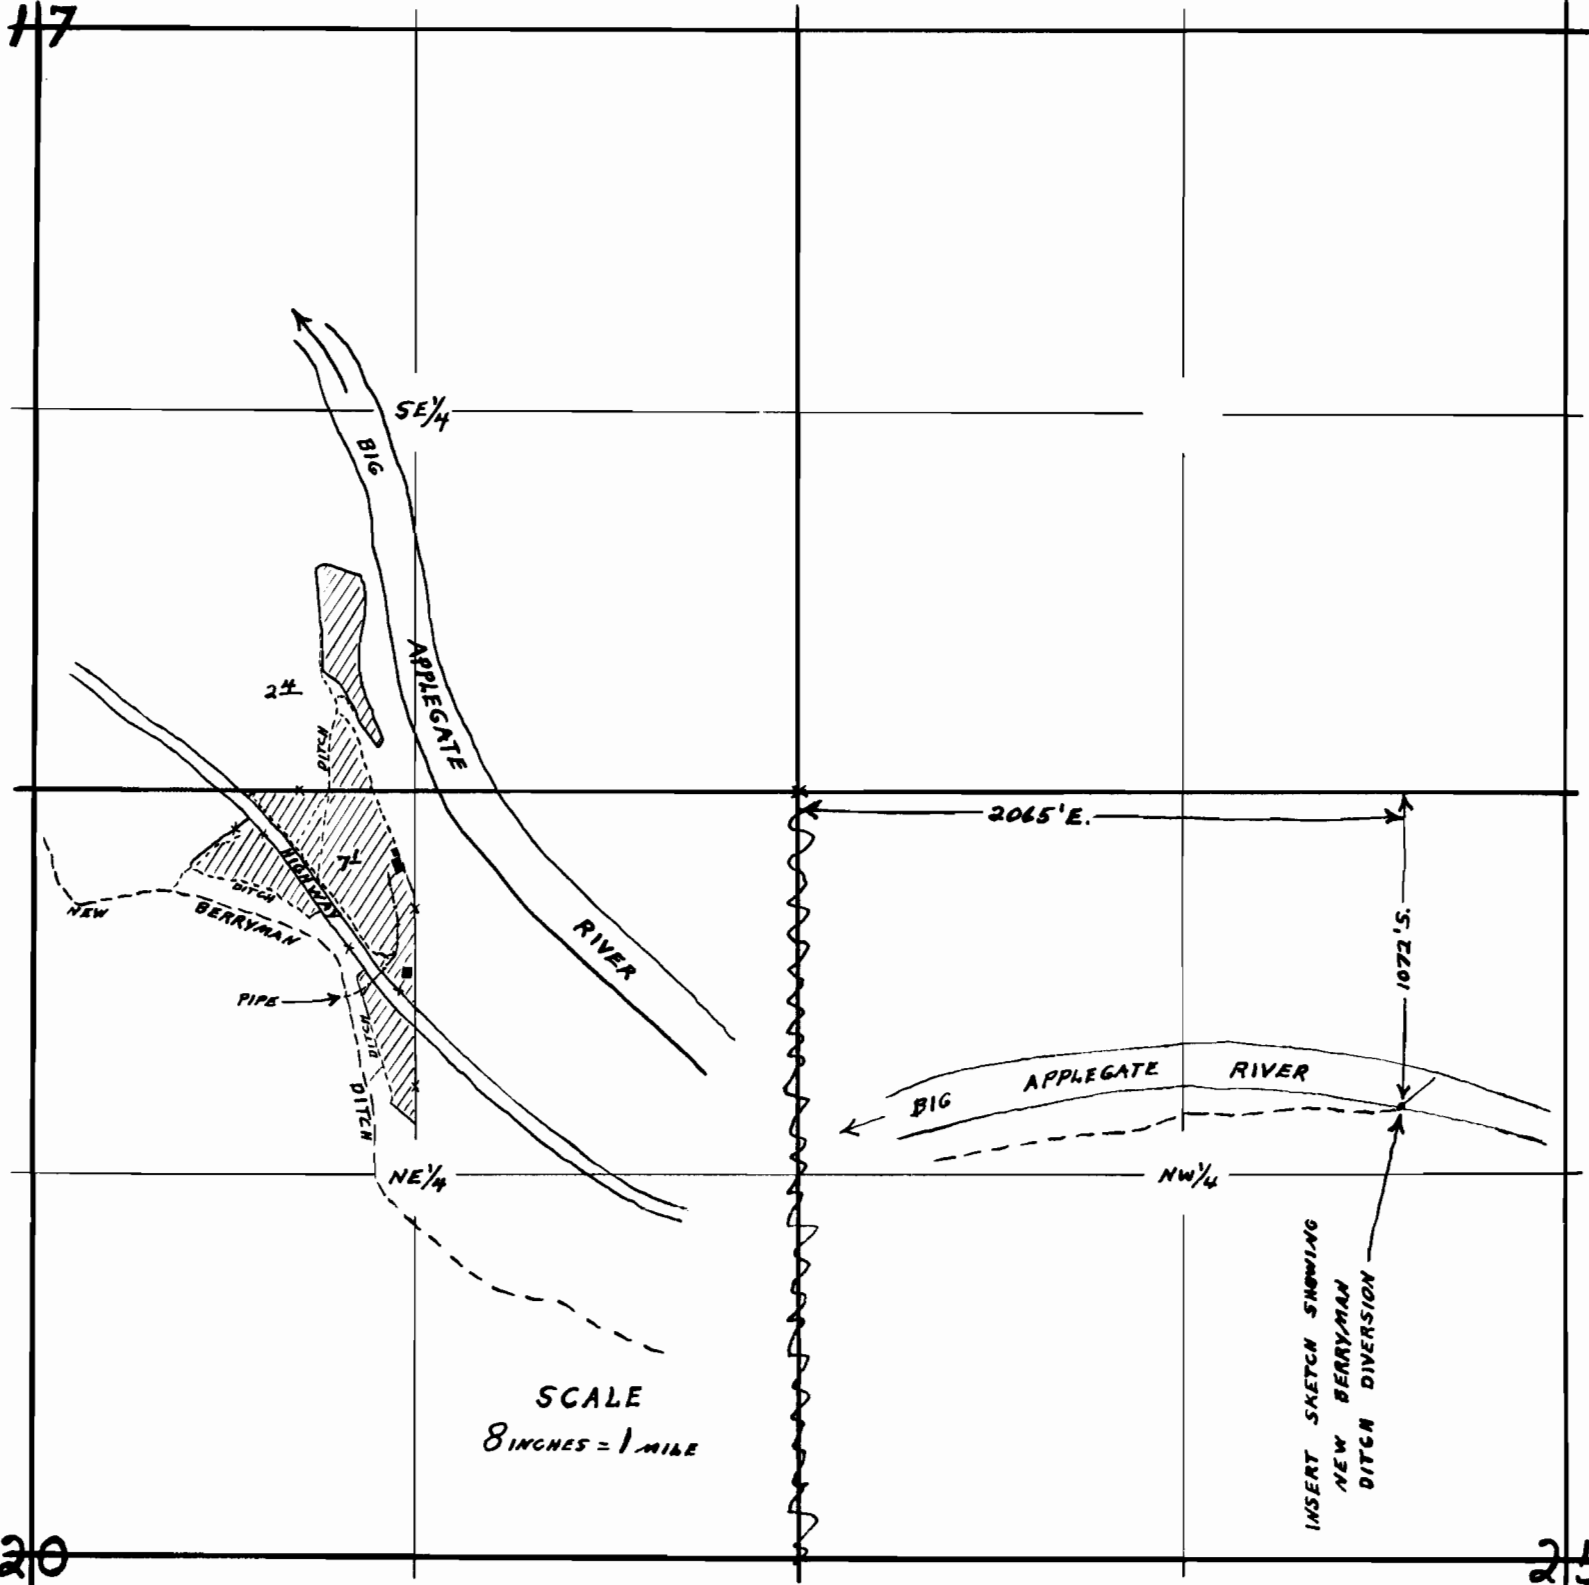

20

25

MAP ACCOMPANYING FINAL PROOF OF
CYRIL C. & LORIS M. MCKAY, FOR USE
OF WATER FROM BIG APPEGATE RIVER
FOR IRRIGATION PURPOSES.

PERMIT NO. 13119
APPLICATION NO. 17425

MAP COPIED FROM PLANE TABLE
SURVEY - MADE 3-3-54.

David L. Hendrix
WATERMASTER DIST. NO. 15