


T.20S. R. 42E. WM

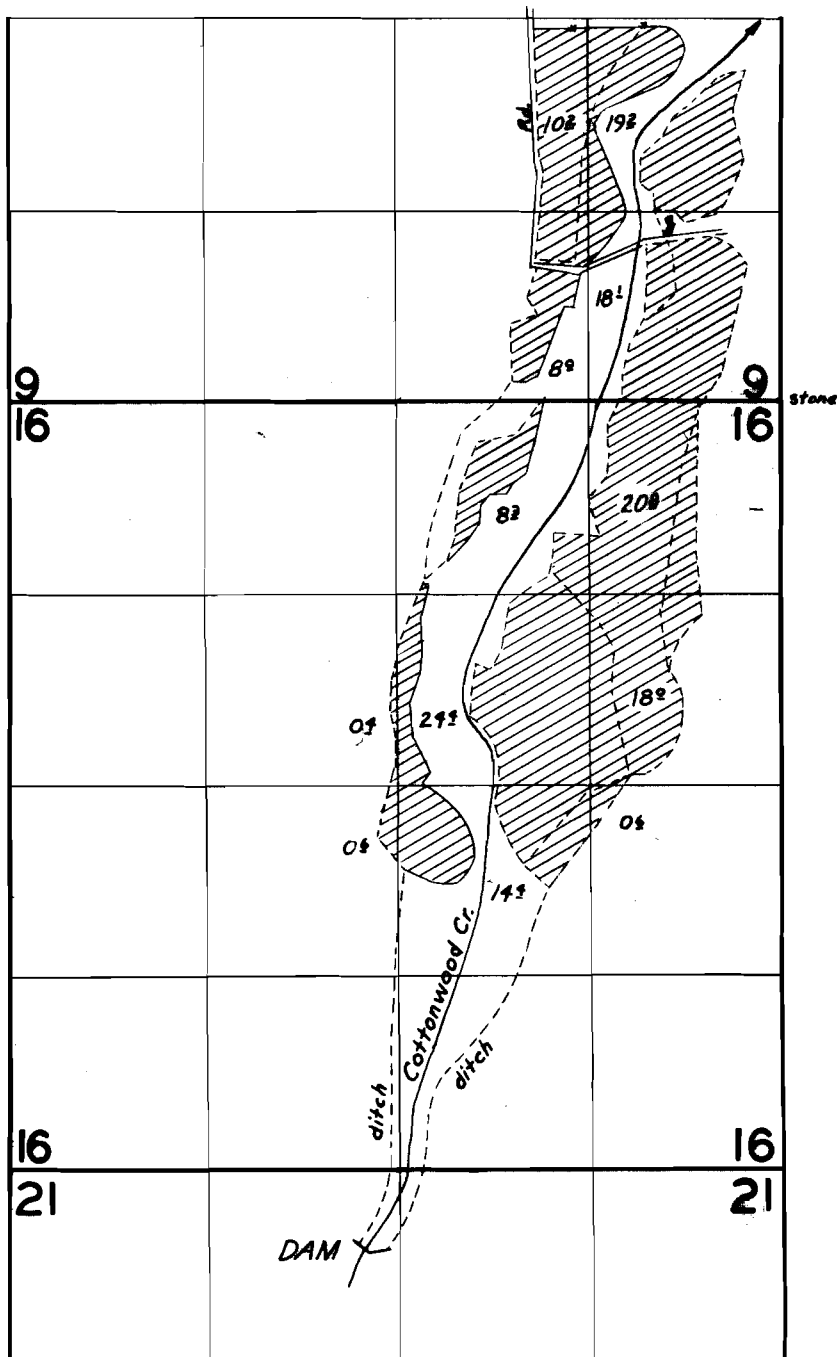

FINAL PROOF SURVEY UNDER

Application No. 16885..... Permit No. 12642.....
IN NAME OF

John Coleman

Surveyed July 23, 1953, by T. Jones