


T.39S. R.23E. W.M.

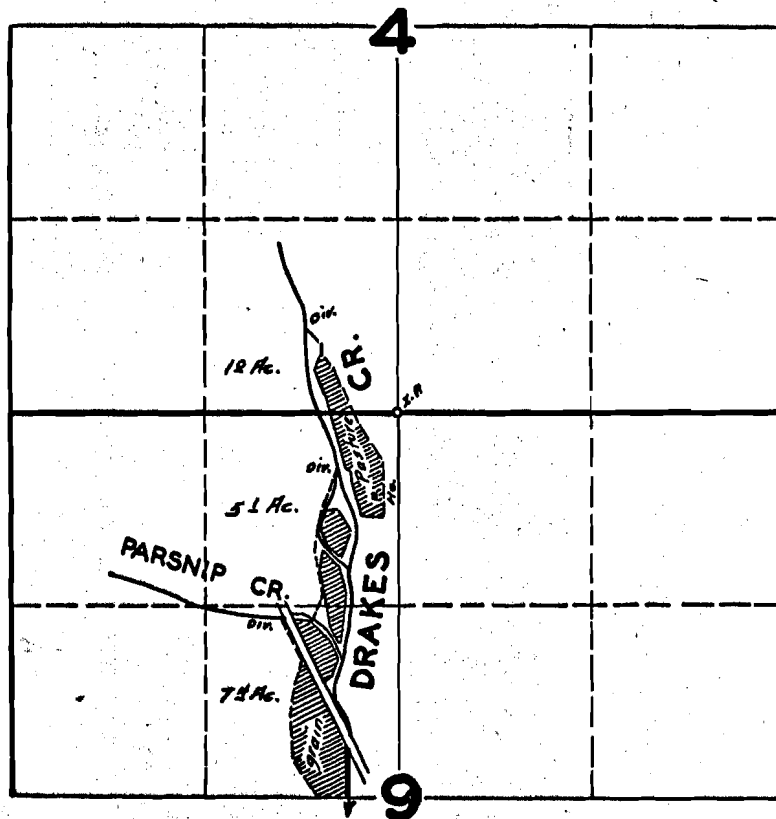

FINAL PROOF SURVEY
UNDER

Application No. 17,771 Permit No. 13458

IN NAME OF

WILLIAM O. MARVINDALE

Surveyed MAY 24 1946, by *[Signature]*

39-23 ✓