


# T.27S. R.3W.WM

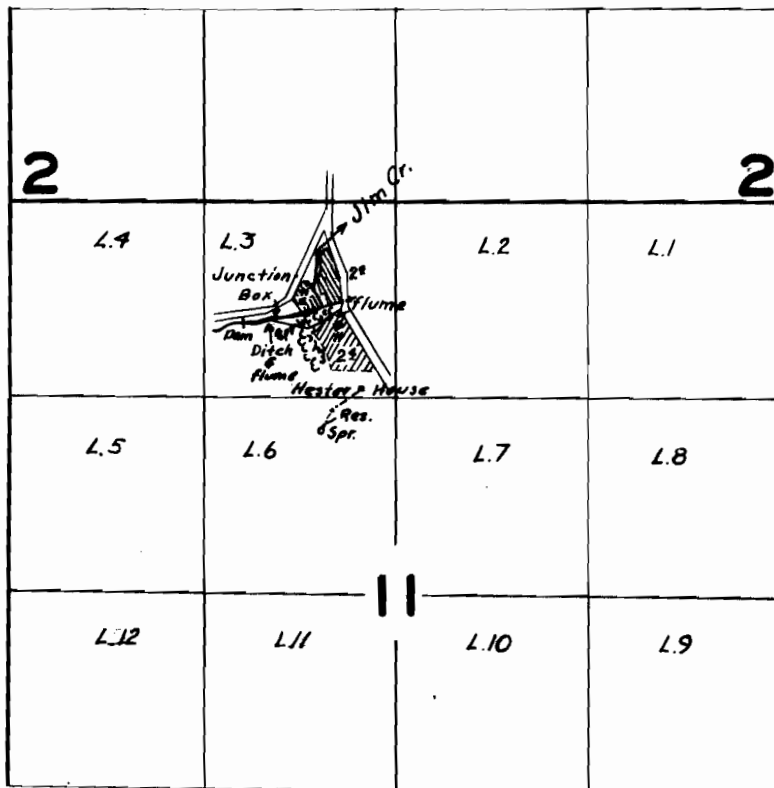

## FINAL PROOF SURVEY

UNDER

20919

16383

Application No. 21866

Permit No. 17231

IN NAME OF

E. A. & GRACE HESTER

ROSA W. WEBB

SETH MATTHEWS



Surveyed Sept. 4 1953, by H. L. Coffman