


# T.40S.R.13E.WM

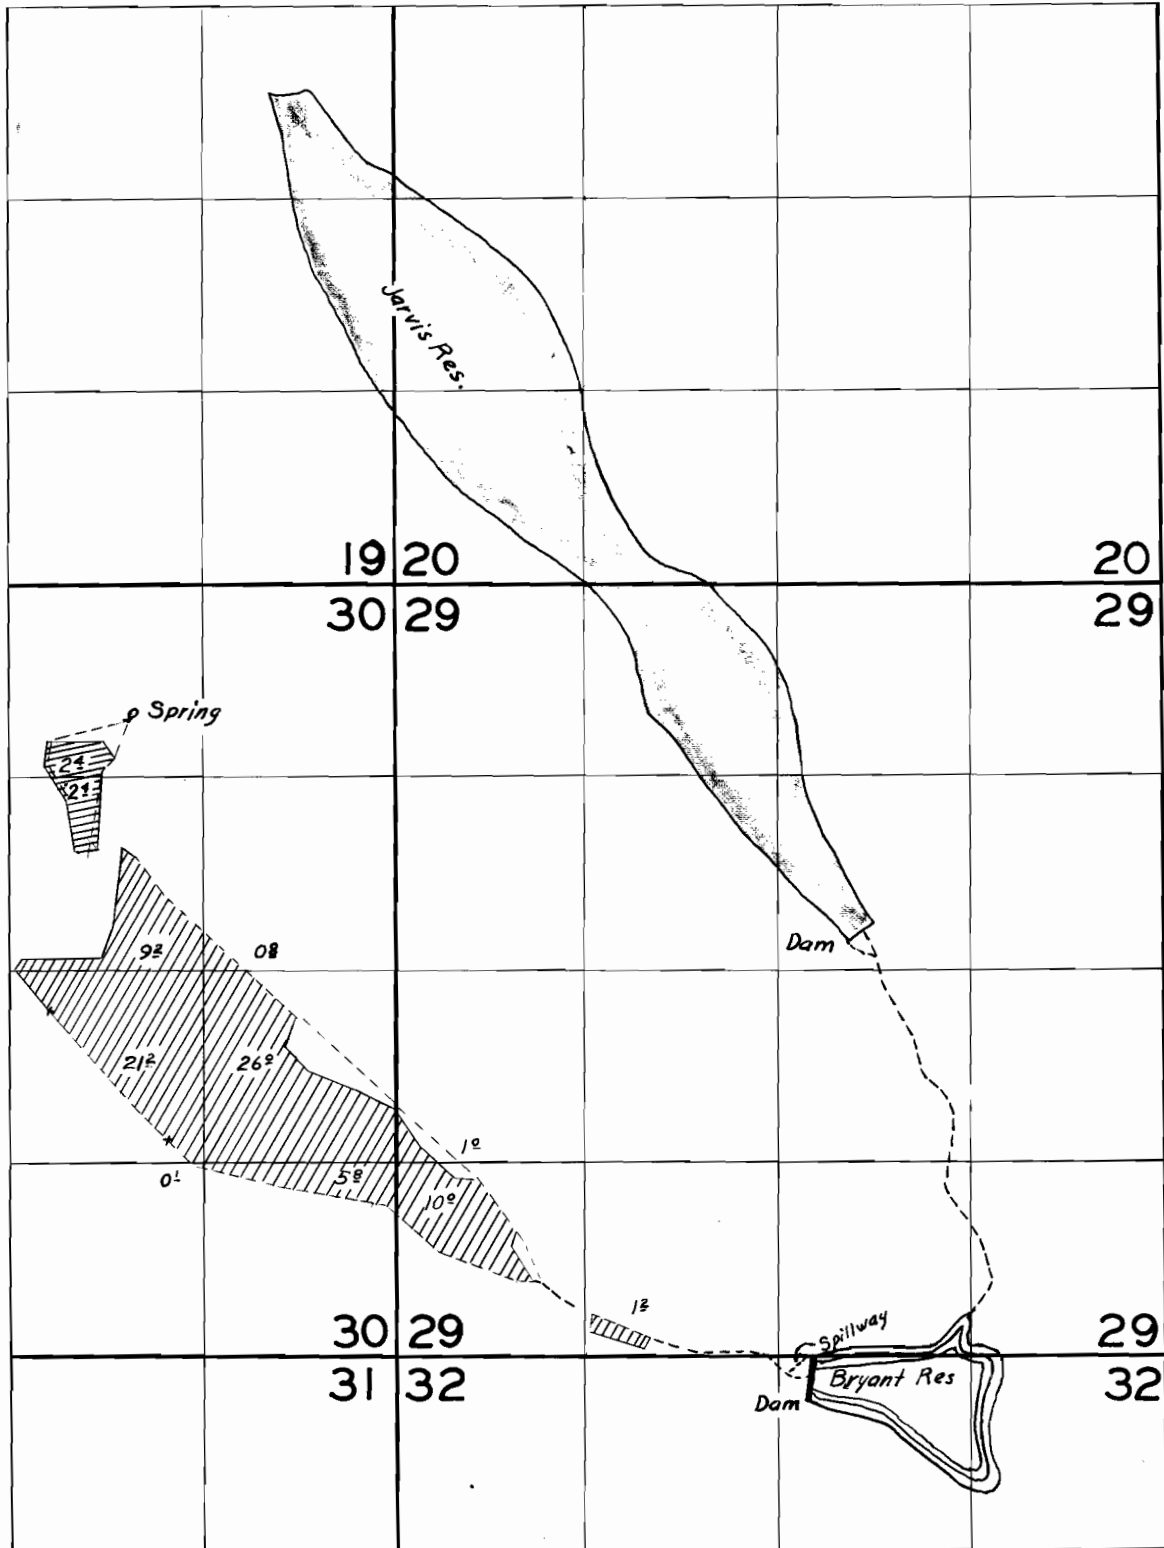

## FINAL PROOF SURVEY UNDER

APPL. NO. 2011 18277 R-18274  PERMIT NO. 15667 14101 R-741

IN NAME OF

LOVENESS LUMBER COMPANY

SURVEYED AUG. 13 1953 BY T. JONES