


T.38S.R.11E.WM

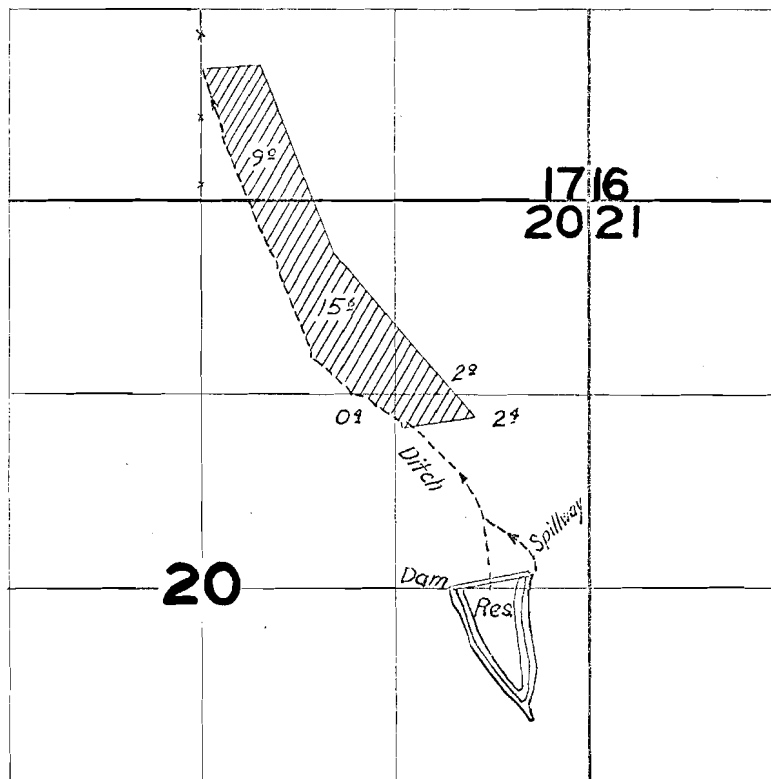

FINAL PROOF SURVEY

UNDER

1-13355

2-253

Application No. 23312 Permit No. 20012

IN NAME OF

.....

Surveyed 19....., by

Buck Lake & Yonka Valley