


R-953
20333

T.38S.R.11E.WM

Buck Cr. : Yuma Valley (2)

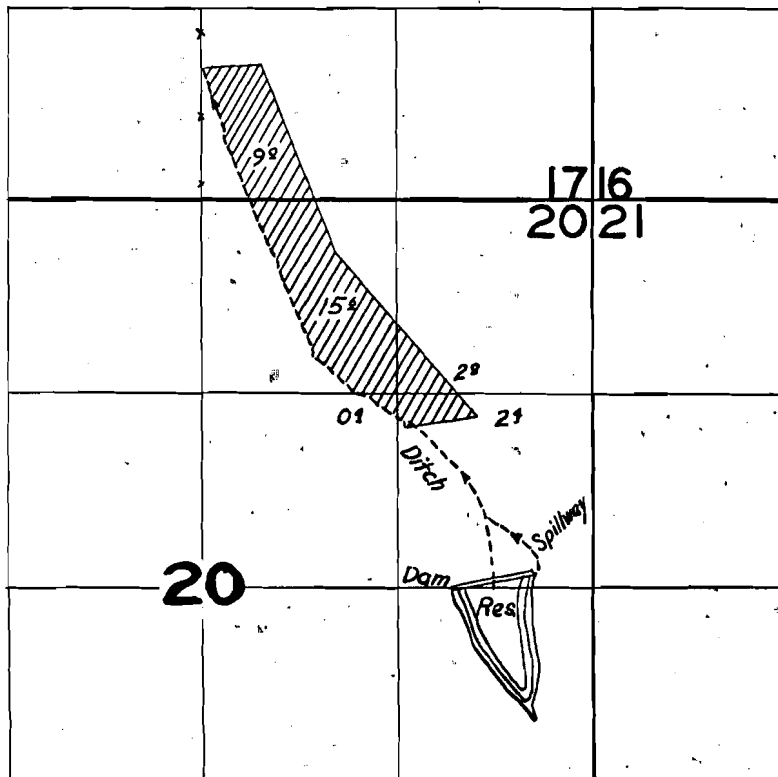

FINAL PROOF SURVEY

UNDER

R-23355

R-953

Application No. 23356 Permit No. 18149

IN NAME OF

H. McCoy Jones

Surveyed Aug. 21 1953, by T. Jones